


1 LOCATION OF WATER WELL: Fraction Section Number Township Number Range Number
 County: Rush SE 1/4 SW 1/4 SW 1/4 25 T 16 S R 16 EW

Distance and direction from nearest town or city street address of well if located within city?
 6 miles north 1/8 east of Otis

2 WATER WELL OWNER: Alen Maier Board of Agriculture, Division of Water Resources
 RR#, St. Address, Box #: Otis, Ks. 67565 Application Number:
 City, State, ZIP Code:

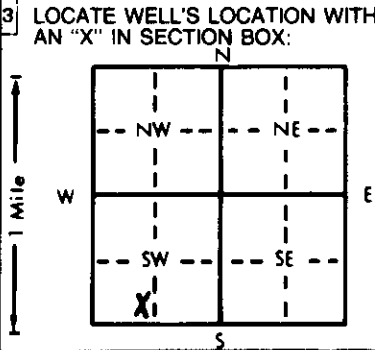

4 DEPTH OF COMPLETED WELL: 260 ft. ELEVATION:
 Depth(s) Groundwater Encountered 1. ft. 2. ft. 3. ft.
 WELL'S STATIC WATER LEVEL: 190 ft. below land surface measured on mo/day/yr 11-15-88
 Pump test data: Well water was ft. after hours pumping gpm
 Est. Yield 5 to 6 gpm: Well water was ft. after hours pumping gpm
 Bore Hole Diameter: 10 in. to 260 ft. and in. to ft.
 WELL WATER TO BE USED AS:
 5 Public water supply 8 Air conditioning 11 Injection well
 1 Domestic 3 Feedlot 6 Oil field water supply 9 Dewatering 12 Other (Specify below)
 2 Irrigation 4 Industrial 7 Lawn and garden only 10 Observation well Stock
 Was a chemical/bacteriological sample submitted to Department? Yes No X; If yes, mo/day/yr sample was submitted
 Water Well Disinfected? Yes hth No

5 TYPE OF BLANK CASING USED:
 1 Steel 3 RMP (SR) 5 Wrought iron 8 Concrete tile CASING JOINTS: Glued X Clamped
 2 PVC 4 ABS 6 Asbestos-Cement 9 Other (specify below) Welded
 7 Fiberglass Threaded
 Blank casing diameter 5 in. to 200 ft. Dia in. to ft. Dia in. to ft.
 Casing height above land surface 12 in. weight SDR-21 lbs./ft. Wall thickness or gauge No.
 TYPE OF SCREEN OR PERFORATION MATERIAL:
 1 Steel 3 Stainless steel 5 Fiberglass 7 PVC 10 Asbestos-cement
 2 Brass 4 Galvanized steel 6 Concrete tile 8 RMP (SR) 11 Other (specify)
 9 ABS 12 None used (open hole)
 SCREEN OR PERFORATION OPENINGS ARE:
 1 Continuous slot 3 Mill slot 5 Gauzed wrapped 8 Saw cut 11 None (open hole)
 2 Louvered shutter 4 Key punched 6 Wire wrapped 9 Drilled holes
 7 Torch cut 10 Other (specify)
 SCREEN-PERFORATED INTERVALS: From 200 ft. to 260 ft. From ft. to ft.
 GRAVEL PACK INTERVALS: From 20 ft. to 260 ft. From ft. to ft.

6 GROUT MATERIAL: 1 Neat cement 2 Cement grout 3 Bentonite 4 Other
 Grout Intervals: From 0 ft. to 20 ft. From ft. to ft. From ft. to ft.
 What is the nearest source of possible contamination:
 1 Septic tank 4 Lateral lines 7 Pit privy 10 Livestock pens 14 Abandoned water well
 2 Sewer lines 5 Cess pool 8 Sewage lagoon 11 Fuel storage 15 Oil well/Gas well
 3 Watertight sewer lines 6 Seepage pit 9 Feedyard 12 Fertilizer storage 16 Other (specify below)
 13 Insecticide storage none
 Direction from well? How many feet?

FROM	TO	LITHOLOGIC LOG	FROM	TO	LITHOLOGIC LOG
0	2 1/2	Top soil			
2 1/2	23	Yellow brown clay			
23	180	Shale			
180	190	White clay			
190	212	White clay and fire clay			
212	217	Sand rock and coal			
217	240	White clay, fire claysome sand rock			
240	260	White clay some shale			
260	275	Shale			

7 CONTRACTOR'S OR LANDOWNER'S CERTIFICATION: This water well was (1) constructed, (2) reconstructed, or (3) plugged under my jurisdiction and was completed on (mo/day/year) 11-18-88 and this record is true to the best of my knowledge and belief. Kansas
 Water Well Contractor's License No. 134 This Water Well Record was completed on (mo/day/yr) 11-30-88
 under the business name of Rosencrantz-Bemis by (signature) Fredia Dedson

INSTRUCTIONS: Use typewriter or ball point pen. PLEASE PRESS FIRMLY and PRINT clearly. Please fill in blanks, underline or circle the correct answers. Send top three copies to Kansas Department of Health and Environment, Office of Oil Field and Environmental Geology, Regulation and Permitting Section, Topeka, Kansas 66620-7500, Telephone: 913-862-9360. Send one to WATER WELL OWNER and retain one for your records.

OFFICE USE ONLY
 T
 R
 EW
 SEC.