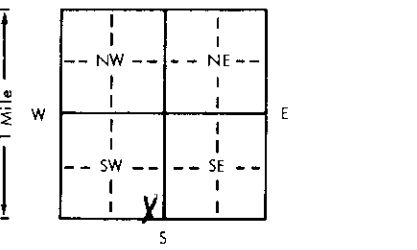


USE TYPEWRITER OR BALL
POINT PEN-PRESS FIRMLY,
PRINT CLEARLY.

WATER WELL RECORD
KSA 82a-1201-1215

Kansas Department of Health and
Environment-Division of Environment
(Water well Contractors)
Topeka, Kansas 66620

1. Location of well: <div style="text-align: center; font-size: 1.2em;">Rush</div>		County: Rush		Fraction: SE 1/4 SE 1/4 SW 1/4		Section number: 27		Township number: 16		Range number: 18		E/W: E/W	
2. Distance and direction from nearest town or city: Street address of well location if in city:				3. Owner of well: Cliff Reeves R.R. or street: RR La Crosse, Ks. City, state, zip code:									
4. Locate with "X" in section below: <div style="text-align: center;">  </div>				Sketch map: County Rd				6. Bore hole dia. 8 in. Completion date 8-18-79 Well depth 210 ft.					
5. Type and color of material				From		To		7. <input checked="" type="checkbox"/> Cable tool <input checked="" type="checkbox"/> Rotary <input type="checkbox"/> Driven <input type="checkbox"/> Dug <input type="checkbox"/> Hollow rod <input type="checkbox"/> Jetted <input type="checkbox"/> Bored <input type="checkbox"/> Reverse rotary					
				0		4		8. Use: <input checked="" type="checkbox"/> Domestic <input type="checkbox"/> Public supply <input type="checkbox"/> Industry <input type="checkbox"/> Irrigation <input type="checkbox"/> Air conditioning <input type="checkbox"/> Stock <input type="checkbox"/> Lawn <input type="checkbox"/> Oil field water <input type="checkbox"/> Other					
				4		38		9. Casing: Material pvc Height: Above or below 24 in. Threaded <input type="checkbox"/> Welded <input checked="" type="checkbox"/> Surface 200 lbs./ft. RMP 5 PVC <input checked="" type="checkbox"/> Weight 200 lbs./ft. Dia. 5 in. to 210 ft. depth Wall thickness 1/2 inches or Dia. 5 in. to 210 ft. depth gage No. 26					
				38		180		10. Screen: Manufacturer's name Jet stream Type pvc Dia. 5 Slot/size 190 .031 Length 20 Set between 210 ft. and 210 ft. Set between 210 ft. and 210 ft. Gravel pack? <input checked="" type="checkbox"/> Size range of material 1/2 - 1/4					
topsoil								11. Static water level: 210 ft. below land surface Date 8-18-79					
whitw dakota clay				180		192		14. Well head completion: 24 inches above grade <input type="checkbox"/> Pitless adapter 24 inches above grade					
white dakota clay with streaks of sandstone				192		210		15. Well grouted? <input checked="" type="checkbox"/> With: <input checked="" type="checkbox"/> Neat cement <input type="checkbox"/> Bentonite <input type="checkbox"/> Concrete Depth: From 0 ft. to 11 ft.					
								16. Nearest source of possible contamination: 400 ft. SW Direction SW Type sewer Well disinfected upon completion? <input checked="" type="checkbox"/> Yes <input type="checkbox"/> No					
								17. Pump: <input checked="" type="checkbox"/> Not installed Manufacturer's name _____ Model number _____ HP _____ Volts _____ Length of drop pipe _____ ft. capacity _____ g.p.m. Type: _____ <input type="checkbox"/> Submersible <input type="checkbox"/> Turbine <input type="checkbox"/> Jet <input type="checkbox"/> Reciprocating <input type="checkbox"/> Centrifugal <input type="checkbox"/> Other					
								18. Water well contractor's certification: This well was drilled under my jurisdiction and this report is true to the best of my knowledge and belief. Karst Water Well 199 Business name E. Hiway 40 Hays, Ks. License No. _____ Address Hays, Ks. Signed Thel Karst Date 8-18-79 Authorized representative					
18. Elevation:				19. Remarks:									
Topography: <input type="checkbox"/> Hill <input type="checkbox"/> Slope <input checked="" type="checkbox"/> Upland <input type="checkbox"/> Valley													

Forward the white, blue and pink copies to the Department of Health and Environment

Form WWC-5