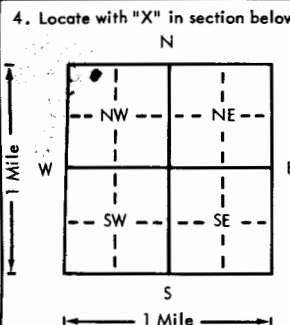
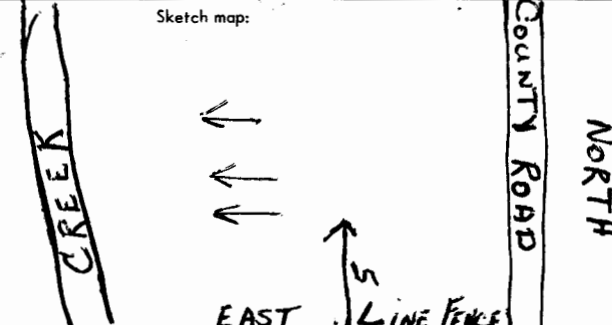


USE TYPEWRITER OR BALL
POINT PEN-PRESS FIRMLY,
PRINT CLEARLY.

WATER WELL RECORD
KSA 82a-1201-1215

Kansas Department of Health and
Environment-Division of Environment
(Water well Contractors)
Topeka, Kansas 66620

1. Location of well:		County Franklin	Fraction NO 1/4 NW 1/4 NW 1/4	Section number 21	Township number 18	Range number 19	E/W E
2. Distance and direction from nearest town or city: 1 MI NORTH 2 3/4 WEST OF OTTAWA KANSAS				3. Owner of well: C. H. BRIDGES R.R. or street: R.R. # City, state, zip code: OTTAWA KANSAS 66067			
4. Locate with "X" in section below:		Sketch map:		6. Bore hole dia. 4 1/4 + 6 1/4 Completion date _____ Well depth 85 ft.			
				7. <input checked="" type="checkbox"/> Cable tool _____ Rotary _____ Driven _____ Dug _____ _____ Hollow rod _____ Jetted _____ Bored _____ Reverse rotary			
5. Type and color of material		From		To		8. Use: <input checked="" type="checkbox"/> Domestic _____ Public supply _____ Industry _____ _____ Irrigation _____ Air conditioning _____ Stock _____ _____ Lawn _____ Oil field water _____ Other	
Soil & joint Clay		15		0		15	
Brown sandy gravel		25		15		40	
Gray sandy shale		25		40		65	
White sand		20		65		85	
Blue lime		85					
						9. Casing: Material _____ Height: Above or below _____ Threaded _____ Welded _____ Surface _____ in. RMP _____ PVC <input checked="" type="checkbox"/> Weight _____ lbs./ft. Dia. _____ in. to _____ ft. depth Wall Thickness: inches or Dia. _____ in. to _____ ft. depth gage No. sch 40	
						10. Screen: Manufacturer's name _____ Type _____ Dia. _____ Slot/gauze _____ Length _____ Set between _____ ft. and _____ ft. _____ ft. and _____ ft. Gravel pack? _____ Size range of material _____	
						11. Static water level: _____ mo./day/yr. _____ ft. below land surface Date _____	
						12. Pumping level below land surfaces: _____ ft. after _____ hrs. pumping _____ g.p.m. _____ ft. after _____ hrs. pumping _____ g.p.m. Estimated maximum yield _____ g.p.m.	
						13. Water sample submitted: _____ mo./day/yr. _____ Yes _____ No Date _____	
						14. Well head completion: _____ _____ Pitless adapter 18" inches above grade	
						15. Well grouted? YES With: _____ Neat cement _____ Bentonite <input checked="" type="checkbox"/> Concrete Depth: From _____ ft. to _____ ft.	
						16. Nearest source of possible contamination: _____ ft. _____ Direction SOUTH Type SEWER Well disinfected upon completion? <input checked="" type="checkbox"/> Yes _____ No	
						17. Pump: _____ Not installed Manufacturer's name _____ Model number _____ HP _____ Volts _____ Length of drop pipe _____ ft. capacity _____ g.p.m. Type: _____ _____ Submersible _____ Turbine _____ Jet _____ Reciprocating _____ Centrifugal _____ Other	
18. Elevation:		19. Remarks:		20. Water well contractor's certification: This well was drilled under my jurisdiction and this report is true to the best of my knowledge and belief. SWANK WATER WELL DRILLING Business name REI PRINCETON KANS. License No. 107 Address George H. Swank Date 8/ Signed _____ Authorized representative			