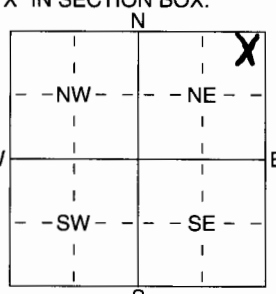


WATER WELL RECORD Form WWC-5 KSA 82a-1212 ID No.

1 LOCATION OF WATER WELL: County: Rush Fraction: NE 1/4 NE 1/4 NE 1/4 Section Number: 36 Township Number: T 16 S Range Number: R 19 EM

Distance and direction from nearest town or city street address of well if located within city?  
3 miles west & 1 mile south of Liebenthal, KS


2 WATER WELL OWNER: Arlene Taylor  
 RR#, St. Address, Box #: 1206 B West 26th Board of Agriculture, Division of Water Resources  
 City, State, ZIP Code: Hays, KS 67601 Application Number:

3 LOCATE WELL'S LOCATION WITH AN "X" IN SECTION BOX:  4 DEPTH OF COMPLETED WELL: 45 ft. ELEVATION: \_\_\_\_\_  
 Depth(s) Groundwater Encountered: 1 26 ft. 2 \_\_\_\_\_ ft. 3 \_\_\_\_\_ ft.  
 WELL'S STATIC WATER LEVEL: 26 ft. below land surface measured on 8-17-05 mo/day/yr  
 Pump test data: Well water was 26 ft. after 2 hours pumping 10 gpm  
 Est. Yield: 10 gpm: Well water was \_\_\_\_\_ ft. after \_\_\_\_\_ hours pumping \_\_\_\_\_ gpm  
 WELL WATER TO BE USED AS:  1 Domestic  2 Irrigation  3 Feedlot  4 Industrial  5 Public water supply  6 Oil field water supply  7 Domestic (lawn & garden)  8 Air conditioning  9 Dewatering  10 Monitoring well  11 Injection well  12 Other (Specify below)  
 Was a chemical/bacteriological sample submitted to Department? Yes \_\_\_\_\_ No X If yes, mo/day/yr sample was submitted \_\_\_\_\_  
 Water Well Disinfected?  Yes  No

5 TYPE OF BLANK CASING USED: 2 1 Steel 3 RMP (SR) 5 Wrought iron 8 Concrete tile CASING JOINTS: Glued X Clamped \_\_\_\_\_  
2 PVC 4 ABS 6 Asbestos-Cement 9 Other (specify below) Welded \_\_\_\_\_  
5 ABS 7 Fiberglass \_\_\_\_\_ Threaded \_\_\_\_\_  
 Blank casing diameter: \_\_\_\_\_ in. to 25 ft., Dia. 2.91 in. to \_\_\_\_\_ ft., Dia. \_\_\_\_\_ in. to \_\_\_\_\_ ft.  
 Casing height above land surface: 12 in., weight \_\_\_\_\_ lbs./ft. Wall thickness or gauge No. .21  
 TYPE OF SCREEN OR PERFORATION MATERIAL: 7 PVC 10 Asbestos-Cement  
 1 Steel 3 Stainless Steel 5 Fiberglass 8 RMP (SR) 11 Other (Specify) \_\_\_\_\_  
 2 Brass 4 Galvanized Steel 6 Concrete tile 9 ABS 12 None used (open hole)  
 SCREEN OR PERFORATION OPENINGS ARE: 8 5 Gauzed wrapped 8 Saw cut 11 None (open hole)  
 1 Continuous slot 3 Mill slot 6 Wire wrapped 9 Drilled holes  
 2 Louvered shutter 4 Key punched 7 Torch cut 10 Other (specify) \_\_\_\_\_  
 SCREEN-PERFORATED INTERVALS: From 45 ft. to 25 ft., From \_\_\_\_\_ ft. to \_\_\_\_\_ ft.  
 GRAVEL PACK INTERVALS: From 45 ft. to 10 ft., From \_\_\_\_\_ ft. to \_\_\_\_\_ ft.  
 From \_\_\_\_\_ ft. to \_\_\_\_\_ ft., From \_\_\_\_\_ ft. to \_\_\_\_\_ ft.

6 GROUT MATERIAL: 0 1 Neat cement 2 Cement grout 3 Bentonite 4 Other \_\_\_\_\_  
 Grout Intervals: From 0 ft. to 10 ft., From \_\_\_\_\_ ft. to \_\_\_\_\_ ft., From \_\_\_\_\_ ft. to \_\_\_\_\_ ft.  
 What is the nearest source of possible contamination: 14 10 Livestock pens 14 Abandoned water well  
 1 Septic tank 4 Lateral lines 7 Pit privy 11 Fuel storage 15 Oil well/Gas well  
 2 Sewer lines 5 Cess pool 8 Sewage lagoon 12 Fertilizer storage 16 Other (specify below)  
 3 Watertight sewer lines 6 Seepage pit 9 Feedyard 13 Insecticide storage  
 Direction from well? \_\_\_\_\_ How many feet? 100 ft.

FROM	TO	LITHOLOGIC LOG	FROM	TO	PLUGGING INTERVALS
0	2	Topsoil			
2	8	topsoil/loose rock			
8	15	Clay/Loose rock			
15	26	Clay			
26	27	Sand/Gravel			
27	30	Clay			
30	33	Clay			
33	35	Limestone/Sand			
35	45	Black Shale			

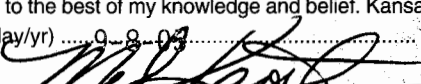7 CONTRACTOR'S OR LANDOWNER'S CERTIFICATION: This water well was (1) constructed, (2) reconstructed, or (3) plugged under my jurisdiction and was completed on (mo/day/yr) 8-30-05 and this record is true to the best of my knowledge and belief. Kansas  
 Water Well Contractor's Licence No. #199 This Water Well Record was completed on (mo/day/yr) 9-8-05  
 under the business name of Karst Water Well Drilling & Service, Inc by (signature) 

INSTRUCTIONS: Use typewriter or ball point pen. PLEASE PRESS FIRMLY and PRINT clearly. Please fill in blanks, underline or circle the correct answers. Send top three copies to Kansas Department of Health and Environment, Bureau of Water, Geology Section, 1000 SW Jackson St., Suite 420, Topeka, Kansas 66612-1367. Telephone 785-296-5522. Send one to WATER WELL OWNER and retain one for your records. Fee of \$5.00 for each constructed well.