

WATER WELL RECORD Form WWC-5


Division of Water Resources App. No.

Well ID

Original Record Correction Change in Well Use

1 LOCATION OF WATER WELL: County: Saline Fraction NE 1/4 SE 1/4 NE 1/4 Section Number 1 Township Number T 16 S Range Number R 2 E W

2 WELL OWNER: Last Name: Reynolds First: Justin Business: Gypsum Valley Sporting Street or Rural Address where well is located: 7726 S Niles Rd Gypsum, Kansas 67448

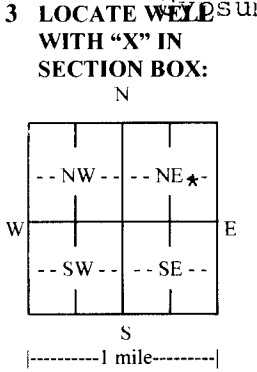

4 DEPTH OF COMPLETED WELL: 54 ft. Depth(s) Groundwater Encountered: 1) 4.1 ft. 2) ... ft. 3) ... ft., or 4) Dry Well WELL'S STATIC WATER LEVEL: 2.9 ft.

5 Latitude: ... (decimal degrees) Longitude: ... (decimal degrees) Datum: WGS 84 NAD 83 NAD 27 Source for Latitude/Longitude: GPS (unit make/model: ...)

6 Elevation: ... ft. Ground Level TOC Source: Land Survey GPS Topographic Map Other

7 WELL WATER TO BE USED AS: 1. Domestic: [X] Household [] Lawn & Garden [] Livestock 2. [] Irrigation 3. [] Feedlot 4. [] Industrial 5. [] Public Water Supply: well ID 6. [] Dewatering: how many wells? 7. [] Aquifer Recharge: well ID 8. [] Monitoring: well ID 9. Environmental Remediation: well ID 10. [] Oil Field Water Supply: lease 11. Test Hole: well ID 12. Geothermal: how many bores? 13. [] Other (specify):

Was a chemical/bacteriological sample submitted to KDHE? [] Yes [X] No If yes, date sample was submitted: Water well disinfected? [X] Yes [] No

8 TYPE OF CASING USED: [] Steel [X] PVC [] Other CASING JOINTS: [X] Glued [] Clamped [] Welded [] Threaded Casing diameter: 5 in. to 6.4 ft., Diameter in. to ft., Diameter in. to ft. Casing height above land surface: 1.6 in. Weight: 200 lbs./ft. Wall thickness or gauge No. 2.50

TYPE OF SCREEN OR PERFORATION MATERIAL: [] Steel [] Stainless Steel [] Fiberglass [X] PVC [] Brass [] Galvanized Steel [] Concrete tile [] None used (open hole) SCREEN OR PERFORATION OPENINGS ARE: [] Continuous Slot [X] Mill Slot [] Gauze Wrapped [] Torch Cut [] Drilled Holes [] Other (Specify) [] Louvered Shutter [] Key Punched [] Wire Wrapped [] Saw Cut [] None (Open Hole) SCREEN-PERFORATED INTERVALS: From 2.4 ft. to 5.4 ft., From ... ft. to ... ft., From ... ft. to ... ft. GRAVEL PACK INTERVALS: From 2.4 ft. to 6.4 ft., From ... ft. to ... ft., From ... ft. to ... ft.

9 GROUT MATERIAL: [] Neat cement [] Cement grout [X] Bentonite [] Other Grout Intervals: From 2 ft. to 2.4 ft., From ... ft. to ... ft., From ... ft. to ... ft.

Nearest source of possible contamination: [] Septic Tank [] Lateral Lines [] Pit Privy [] Livestock Pens [] Insecticide Storage [X] Sewer Lines [] Cess Pool [] Sewage Lagoon [] Fuel Storage [] Abandoned Water Well [] Watertight Sewer Lines [] Seepage Pit [] Feedyard [] Fertilizer Storage [] Oil Well/Gas Well [] Other (Specify)

Direction from well? NORTH Distance from well? 300 to 900 approx ft.

Table with columns: FROM, TO, LITHOLOGIC LOG, FROM, TO, LITHO. LOG (cont.) or PLUGGING INTERVALS. Rows include: 0-9 BROWN CLAY, 9-17 LITE COLOR SHALE, 17-18 LITE COLOR LIMESTONE, 18-24 LITE COLOR SHALE, 24-29 GRAY SHALE, 29-41 HARD DARK SHALE, 41-42 SOFT CLAY, 42-54 GRAY SHALE. Notes: ...

11 CONTRACTOR'S OR LANDOWNER'S CERTIFICATION: This water well was [X] constructed, [] reconstructed, or [] plugged under my jurisdiction and was completed on (mo-day-year) 3/20/14 and this record is true to the best of my knowledge and belief. Kansas Water Well Contractor's License No. 397 This Water Well Record was completed on (mo-day-year) 3/22/14 under the business name of CENTRAL KANSAS DRILLING