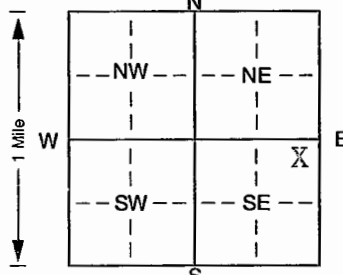


1] LOCATION OF WATER WELL: Fraction NE 1/4 NE 1/4 SE 1/4 Section Number 17 Township Number T 16 S Range Number R 23 E/W
 County: Ness

Distance and direction from nearest town or city street address of well if located within city?
2 1/2 east, 1 1/2 north of Ransom, KS

2] WATER WELL OWNER: Alex Nichepor
 RR#, St. Address, Box # : RR 1 - Box 175 Board of Agriculture, Division of Water Resources
 City, State, ZIP Code : Ness City, KS 67560 Application Number:

3] LOCATE WELL'S LOCATION WITH AN "X" IN SECTION BOX:

 4] DEPTH OF COMPLETED WELL: 22 . 55 . ft. ELEVATION:
 Depth(s) Groundwater Encountered 1. 29 . ft. 2. NA . ft. 3. 8-1-02 . ft.
 WELL'S STATIC WATER LEVEL 29 . ft. below land surface measured on mo/day/yr 8-1-02
 Pump test data: Well water was NA . ft. after NA . hours pumping NA . gpm
 Est. Yield NA . gpm: Well water was NA . ft. after NA . hours pumping NA . gpm
 Bore Hole Diameter. 9 . in. to 55 . ft., and NA . in. to NA . ft.
 WELL WATER TO BE USED AS: 5 Public water supply 8 Air conditioning 11 Injection well
 1 Domestic 3 Feedlot 6 Oil field water supply 9 Dewatering 12 Other (Specify below)
 2 Irrigation 4 Industrial 7 Domestic (lawn & garden) 10 Monitoring well
 Was a chemical/bacteriological sample submitted to Department? Yes. NA . No. X . ; If yes, mo/day/yrs sample was submitted NA .
 Water Well Disinfected? Yes NA . No X .

5] TYPE OF BLANK CASING USED:
 1 Steel 3 RMP (SR) 5 Wrought iron 8 Concrete tile CASING JOINTS: Glued. X . Clamped. NA .
 2 PVC 4 ABS 6 Asbestos-Cement 9 Other (specify below) Welded NA .
 7 Fiberglass Threaded NA .
 Blank casing diameter 5 . in. to 30 . ft., Dia NA . in. to NA . ft., Dia NA . in. to NA . ft.
 Casing height above land surface 24 . in., weight SDR-26 . lbs./ft. Wall thickness or gauge No. NA .
 TYPE OF SCREEN OR PERFORATION MATERIAL:
 1 Steel 3 Stainless steel 5 Fiberglass 7 PVC 10 Asbestos-cement
 2 Brass 4 Galvanized steel 6 Concrete tile 8 RMP (SR) 11 Other (specify) NA .
 9 ABS 12 None used (open hole)
 SCREEN OR PERFORATION OPENINGS ARE:
 1 Continuous slot 3 Mill slot 5 Gauzed wrapped 8 Saw cut 11 None (open hole)
 2 Louvered shutter 4 Key punched 6 Wire wrapped 9 Drilled holes
 7 Torch cut 10 Other (specify) NA . ft.
 SCREEN-PERFORATED INTERVALS: From 55 . ft. to 33 . ft., From NA . ft. to NA . ft.
 From NA . ft. to NA . ft., From NA . ft. to NA . ft.
 GRAVEL PACK INTERVALS: From 55 . ft. to 20 . ft., From NA . ft. to NA . ft.
 From NA . ft. to NA . ft., From NA . ft. to NA . ft.

6] GROUT MATERIAL: 1 Neat cement 2 Cement grout 3 Bentonite 4 Other hole plug
 Grout Intervals: From 20 . ft. to 0 . ft., From NA . ft. to NA . ft., From NA . ft. to NA . ft.
 What is the nearest source of possible contamination:
 1 Septic tank 4 Lateral lines 7 Pit privy 10 Livestock pens 14 Abandoned water well
 2 Sewer lines 5 Cess pool 8 Sewage lagoon 11 Fuel storage 15 Oil well/Gas well
 3 Watertight sewer lines 6 Seepage pit 9 Feedyard 12 Fertilizer storage 16 Other (specify below) Windmill
 13 Insecticide storage
 Direction from well? East How many feet? 75 ft.

FROM	TO	LITHOLOGIC LOG	FROM	TO	PLUGGING INTERVALS
0	3	top soil			
3	15	gravel, brown clay, and white rock			
15	21	tan clay			
21	27	sand and gravel, small, dark			
27	50	sandy tan clay, gravel mix			
50	55	gray and yellow shale			

7] CONTRACTOR'S OR LANDOWNER'S CERTIFICATION: This water well was (1) constructed, (2) reconstructed, or (3) plugged under my jurisdiction and was completed on (mo/day/year) 8-1-02 and this record is true to the best of my knowledge and belief. Kansas Water Well Contractor's Licence No. 134 This Water Well Record was completed on (mo/day/yr) 8-8-02 under the business name of Rosencrantz-Bemis by (signature) Freddie Hudson