


1	LOCATION OF WATER WELL:	Fraction	Section Number	Township Number	Range Number
	County: <u>Ness</u>	<u>NE 1/4 NW 1/4</u>	<u>32 15</u>	<u>23 W</u>	E/W

Distance and direction from nearest town or city street address of well if located within city?

2	WATER WELL OWNER:	Board of Agriculture, Division of Water Resources
	<u>Craig Blocksome - contact - also Rod, Kent, Elizabeth, Bettie, Carol Blocksome</u>	Application Number:
	RR #, St. Address, Box #: <u>Rt 1 Box 120</u>	
	City, State, ZIP Code: <u>Ransom, KS 67572</u>	

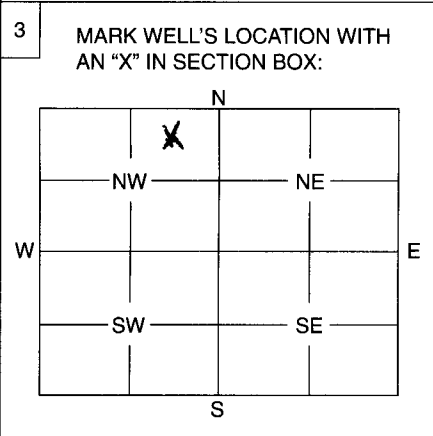

4	DEPTH OF WELL	<u>44 1/2</u> ft.
	WELL'S STATIC WATER LEVEL	<u>25 3/4</u> ft.
WELL WAS USED AS:		
<input checked="" type="checkbox"/> 1 Domestic	<input type="checkbox"/> 5 Public Water Supply	<input type="checkbox"/> 9 Dewatering
<input checked="" type="checkbox"/> 2 Irrigation	<input type="checkbox"/> 6 Oil Field Water Supply	<input type="checkbox"/> 10 Monitoring Well
<input checked="" type="checkbox"/> 3 Feedlot	<input type="checkbox"/> 7 Domestic (Lawn & Garden)	<input type="checkbox"/> 11 Injection Well
<input type="checkbox"/> 4 Industrial	<input type="checkbox"/> 8 Air Conditioning	<input type="checkbox"/> 12 Other
Was a chemical / bacteriological sample submitted to Department? Yes No <input checked="" type="checkbox"/>		
If yes, mo/day/yr sample was submitted		
Water Well Disinfected: Yes <input checked="" type="checkbox"/> No		

5	TYPE OF BLANK CASING USED:
	<input checked="" type="checkbox"/> 1 Steel <input type="checkbox"/> 3 RMP (SR) <input type="checkbox"/> 5 Wrought <input type="checkbox"/> 7 Fiberglass <input type="checkbox"/> 9 Other (Specify below) <input type="checkbox"/> 2 PVC <input type="checkbox"/> 4 ABS <input type="checkbox"/> 6 Asbestos-Cement <input type="checkbox"/> 8 Concrete Tile
	Blank casing diameter in. Was casing pulled? Yes <input checked="" type="checkbox"/> No <input type="checkbox"/> If yes, how much <u>3 1/2 ft.</u>
	Casing height above or below land surface <u>6 above</u> ft.

6	GROUT PLUG MATERIAL:	<input type="checkbox"/> 1 Neat cement	<input type="checkbox"/> 2 Cement grout	<input checked="" type="checkbox"/> 3 Bentonite	<input type="checkbox"/> 4 Other
	Grout Plug Intervals:	From <u>3</u> ft. to <u>6</u> ft.,	From ft. to ft.,	From ft. to ft.,	From ft. to ft.
What is the nearest source of possible contamination:					
<input type="checkbox"/> 1 Septic tank	<input type="checkbox"/> 6 Seepage pit	<input type="checkbox"/> 11 Fuel storage	<input type="checkbox"/> 16 Other (specify below)		
<input type="checkbox"/> 2 Sewer lines	<input type="checkbox"/> 7 Pit privy	<input type="checkbox"/> 12 Fertilizer storage			
<input type="checkbox"/> 3 Watertight sewer lines	<input type="checkbox"/> 8 Sewage lagoon	<input type="checkbox"/> 13 Insecticide storage			
<input type="checkbox"/> 4 Lateral lines	<input type="checkbox"/> 9 Feedyard	<input type="checkbox"/> 14 Abandoned water well			
<input type="checkbox"/> 5 Cess pool	<input checked="" type="checkbox"/> 10 Livestock pens	<input type="checkbox"/> 15 Oil well/Gas well			
Direction from well? <u>approx 50 NE</u> How many feet? <u>approx 50</u>					

FROM	TO	PLUGGING MATERIALS
<u>44 1/2</u>	<u>24</u>	<u>Clean Sand</u>
<u>24</u>	<u>0</u>	<u>Sub soil</u>
<u>6</u>	<u>3</u>	<u>Bentonite</u>
<u>3</u>	<u>0</u>	<u>Soil</u>

7	CONTRACTOR'S OF LANDOWNER'S CERTIFICATION: This water well was plugged under my jurisdiction and was completed on (mo/day/year) <u>5-29-2007</u> and this record is true to the best of my knowledge and belief. Kansas Water Well Contractor's License No. This Water Well Record was completed on (mo/day/year) <u>6-6-2007</u> under the business name of by (signature) <u>Richard Craig Blocksome</u>
---	---

INSTRUCTIONS: Use typewriter or ball point pen. Please press firmly and print clearly. Please fill in blanks, underline or circle the correct answers. Send top three copies to Kansas Department of Health and Environment, Bureau of Water, Geology Section, 1000 SW Jackson St., Ste. 420, Topeka, Kansas 66612-1367. Telephone: 785/296-5522. Send one to Water Well Owner and retain one for your records.