

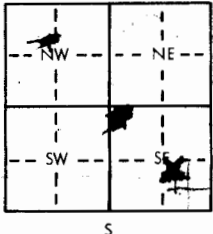
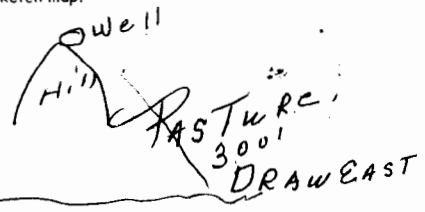
USE TYPEWRITER OR BALL  
POINT PEN-PRESS FIRMLY,  
PRINT CLEARLY.

WATER WELL RECORD  
KSA 82a-1201-1215

GREAT BLEND

1-250,000

Kansas Department of Health and  
Environment-Division of Environment  
(Water well Contractors)  
Topeka, Kansas 66620

1. Location of well: County <u>NESS</u> Fraction <u>NW 1/4 SE 1/4 SE 1/4</u> Section number <u>5</u> Township number <u>T 16 S</u> Range number <u>R 24 E</u>	
2. Distance and direction from nearest town or city: <u>3 West &amp; 5 North of Ransom</u>	
3. Owner of well: <u>AMBROSE KEFFLINGER</u> R.R. or street: <u>RANSOM, KS 67572</u> City, state, zip code: <u>RANSOM, KS 67572</u>	
4. Locate with "X" in section below:  Sketch map: 	
5. Type and color of material	
6. Bore hole dia. <u>9</u> in. Completion date <u>9/26/78</u> Well depth <u>22</u> ft.	
7. <u>X</u> Cable tool <u>X</u> Rotary <u>  </u> Driven <u>  </u> Dug <u>  </u> <u>  </u> Hollow rod <u>  </u> Jetted <u>  </u> Bored <u>  </u> Reverse rotary <u>  </u>	
8. Use: <u>  </u> Domestic <u>  </u> Public supply <u>  </u> Industry <u>  </u> <u>  </u> Irrigation <u>  </u> Air conditioning <u>X</u> Stock <u>  </u> <u>  </u> Lawn <u>  </u> Oil field water <u>  </u> Other <u>  </u>	
9. Casing: Material <u>PLASTIC</u> Height <u>Above</u> or below <u>  </u> Threaded <u>  </u> Welded <u>  </u> Surface <u>  </u> in. <u>  </u> RMP <u>  </u> PVC <u>X</u> Weight <u>  </u> lbs./ft. <u>  </u> Dia. <u>5</u> in. to <u>22</u> ft. depth Wall Thickness: inches or <u>  </u> Dia. <u>  </u> in. to <u>  </u> ft. depth gage No. <u>250</u>	
10. Screen: Manufacturer's name <u>CROWN</u> <u>LINE PLASTIC, INC.</u> Type <u>PLASTIC</u> Dia. <u>5"</u> Slot/gauze <u>1/16</u> Length <u>10'</u> Set between <u>22</u> ft. and <u>12</u> ft. <u>  </u> ft. and <u>  </u> ft. Gravel pack? <u>yes</u> Size range of material <u>4-5/8"</u>	
11. Static water level: <u>X</u> <u>13</u> ft. below land surface Date <u>9/26/78</u> <u>  </u> mo./day/yr.	
12. Pumping level below land surfaces: <u>Not Pumped</u> <u>  </u> ft. after <u>  </u> hrs. pumping <u>  </u> g.p.m. <u>  </u> ft. after <u>  </u> hrs. pumping <u>  </u> g.p.m. Estimated maximum yield <u>  </u> g.p.m.	
13. Water sample submitted: <u>  </u> mo./day/yr. <u>  </u> Yes <u>X</u> No Date <u>  </u>	
14. Well head completion: <u>NOT DONE</u> <u>  </u> Pitless adapter <u>  </u> Inches above grade	
15. Well grouted? <u>yes</u> With: <u>X</u> Neat cement <u>  </u> Bentonite <u>  </u> Concrete <u>  </u> Depth: From <u>0</u> ft. to <u>10</u> ft.	
16. Nearest source of possible contamination: <u>DRAW</u> ft. <u>300'</u> Direction <u>EAST</u> Type <u>UNKNOWN</u> Well disinfected upon completion? <u>X</u> Yes <u>  </u> No <u>  </u>	
17. Pump: <u>X</u> Not installed Manufacturer's name <u>  </u> Model number <u>  </u> HP <u>  </u> Volts <u>  </u> Length of drop pipe <u>  </u> ft. capacity <u>  </u> g.p.m. Type: <u>  </u> Submersible <u>  </u> Turbine <u>  </u> <u>  </u> Jet <u>  </u> Reciprocating <u>  </u> <u>  </u> Centrifugal <u>  </u> Other <u>  </u>	
18. Elevation: <u>  </u> Topography: <u>X</u> Hill <u>  </u> Slope <u>  </u> Upland <u>  </u> Valley <u>  </u>	
19. Remarks: <u>CONCRETE SLAB TO BE</u> <u>INSTALLED BY CUSTOMER</u> <u>AT SURFACE OF GROUND</u>	
20. Water well contractor's certification: This well was drilled under my jurisdiction and this report is true to the best of my knowledge and belief. <u>DEL. DRILLING CO. 303</u> Business name <u>  </u> License No. <u>  </u> Address <u>368 Hill City, KS 67642</u> Signed <u>Allen J. Jones</u> Date <u>9/26/78</u> Authorized representative	

Forward the white, blue and pink copies to the Department of Health and Environment

Form WWC-5