WATER WELL RECORD Form WWC-5 KSA 82a-1212

1 LOCATION OF WATER WELL: Fraction: NE ¼ NE ¼ NE ¼ | Section Number: 6 | Township Number: T 16 S | Range Number: R 28 E/W

County: Lane

Distance and direction from nearest town or city street address of well if located within city?

2 WATER WELL OWNER: Pete James

RR#, St. Address, Box # : 245 N. 3rd

City, State, ZIP Code : Dighton, Ks. 67839

Board of Agriculture, Division of Water Resourc

Application Number:

3 LOCATE WELL'S LOCATION WITH AN "X" IN SECTION BOX:

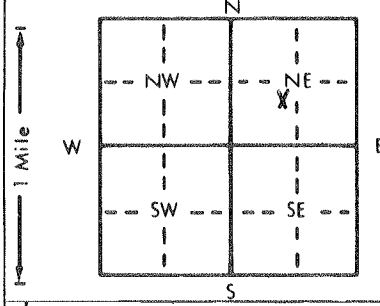

4 DEPTH OF COMPLETED WELL 15' ft. ELEVATION:

Depth(s) Groundwater Encountered 1. ft. 2. ft. 3. ft

WELL'S STATIC WATER LEVEL 8 ft. below land surface measured on mo/day/yr

Pump test data: Well water was ft. after hours pumping gpi

Est. Yield gpm: Well water was ft. after hours pumping gpi

Bore Hole Diameter in. to ft., and in. to

WELL WATER TO BE USED AS: 1 Domestic 2 Irrigation 3 Feedlot 4 Industrial 5 Public water supply 6 Oil field water supply 7 Lawn and garden only 8 Air conditioning 9 Dewatering 10 Monitoring well 11 Injection well 12 Other (Specify below)

Was a chemical/bacteriological sample submitted to Department? Yes No X; If yes, mo/day/yr sample was submitted

Water Well Disinfected? Yes X No

5 TYPE OF BLANK CASING USED: 1 Steel 2 PVC 3 RMP (SR) 4 ABS 5 Wrought iron 6 Asbestos-Cement 7 Fiberglass 8 Concrete tile 9 Other (specify below)

CASING JOINTS: Glued Clamped Welded Threaded

Blank casing diameter 5 in. to ft., Dia in. to ft., Dia in. to

Casing height above land surface 6' below in., weight lbs./ft. Wall thickness or gauge No.

TYPE OF SCREEN OR PERFORATION MATERIAL: 1 Steel 2 Brass 3 Stainless steel 4 Galvanized steel 5 Fiberglass 6 Concrete tile 7 PVC 8 RMP (SR) 9 ABS 10 Asbestos-cement 11 Other (specify) NA 12 None used (open hole)

SCREEN OR PERFORATION OPENINGS ARE: 1 Continuous slot 2 Louvered shutter 3 Mill slot 4 Key punched 5 Gauzed wrapped 6 Wire wrapped 7 Torch cut 8 Saw cut 9 Drilled holes 10 Other (specify) NA 11 None (open hole)

SCREEN-PERFORATED INTERVALS: From NA ft. to NA ft., From ft. to

From ft. to ft., From ft. to

GRAVEL PACK INTERVALS: From ft. to ft., From ft. to

From ft. to ft., From ft. to

6 GROUT MATERIAL: 1 Neat cement 2 Cement grout 3 Bentonite 4 Other

Grout Intervals: From 8 ft. to 3 ft., From ft. to ft., From ft. to ft.

What is the nearest source of possible contamination:

1 Septic tank 2 Sewer lines 3 Watertight sewer lines 4 Lateral lines 5 Cess pool 6 Seepage pit 7 Pit privy 8 Sewage lagoon 9 Feedyard 10 Livestock pens 11 Fuel storage 12 Fertilizer storage 13 Insecticide storage 14 Abandoned water well 15 Oil well/Gas well 16 Other (specify below)

Direction from well? How many feet?

FROM	TO	LITHOLOGIC LOG	FROM	TO	PLUGGING INTERVALS
15	8	Chlorinated Sand			
8	3	Bentonite Plug			
3	0	Top Soil			

7 CONTRACTOR'S OR LANDOWNER'S CERTIFICATION: This water well was (1) constructed, (2) reconstructed, or (3) plugged under my jurisdiction and w completed on (mo/day/year) 5-10-92 and this record is true to the best of my knowledge and belief. Kans

Water Well Contractor's License No. 514 This Water Well Record was completed on (mo/day/yr) 5-14-92

under the business name of Miller Gearhead & Pump, Inc. by (signature) Everett Miller

INSTRUCTIONS: Use typewriter or ball point pen. *PLEASE PRESS FIRMLY* and *PRINT* clearly. Please fill in blanks, underline or circle the correct answers. Send top three copies to Kansas Department of Health and Environment, Bureau of Water, Topeka, Kansas 66620-0001. Telephone: 913-296-5545. Send one to WATER WELL OWNER and retain one for your records.