


WATER WELL RECORD Form WWC-5 " KSA 82a-1212

LOCATION OF WATER WELL: Fraction SE 1/4 SW 1/4 ST 1/4 Section Number 32 Township Number T 16 S Range Number R 28 EW  
 County: Jane  
 Distance and direction from nearest town or city street address of well if located within city?  
500 feet South of Shields, Kansas

WATER WELL OWNER: Wilson Township Hall  
 #, St. Address, Box # :  
 City, State, ZIP Code : Shields, Kansas 67874  
 Board of Agriculture, Division of Water Resources  
 Application Number:

LOCATE WELL'S LOCATION WITH AN "X" IN SECTION BOX:

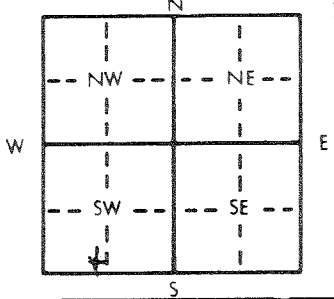

DEPTH OF COMPLETED WELL: 122 ft. ELEVATION: .....  
 Depth(s) Groundwater Encountered 1. 94 ft. 2. .... ft. 3. .... ft.  
 WELL'S STATIC WATER LEVEL 94 ft. below land surface measured on mo/day/yr 5/29/95  
 Na Pump test data: Well water was ..... ft. after ..... hours pumping ..... gpm  
 Est. Yield ..... gpm: Well water was ..... ft. after ..... hours pumping ..... gpm  
 Bore Hole Diameter 9 in. to 122 ft., and ..... in. to ..... ft.  
 WELL WATER TO BE USED AS:  
 1 Domestic 3 Feedlot 6 Oil field water supply 9 Dewatering 12 Other (Specify below)  
 2 Irrigation 4 Industrial 7 Lawn and garden only 10 Observation well  
 Was a chemical/bacteriological sample submitted to Department? Yes ..... No X .....; If yes, mo/day/yr sample was submitted  
 Water Well Disinfected? Yes X No

TYPE OF BLANK CASING USED:  
 1 Steel 3 RMP (SR) 5 Wrought iron 8 Concrete tile CASING JOINTS: Glued Clamped  
 2 PVC 4 ABS 6 Asbestos-Cement 9 Other (specify below) Welded  
 7 Fiberglass Threaded

Blank casing diameter 5 in. to 102 ft., Dia ..... in. to ..... ft., Dia ..... in. to ..... ft.  
 Casing height above land surface 12 in., weight 2.9 lbs./ft. Wall thickness or gauge No. 265

TYPE OF SCREEN OR PERFORATION MATERIAL:  
 1 Steel 3 Stainless steel 5 Fiberglass 7 PVC 10 Asbestos-cement  
 2 Brass 4 Galvanized steel 6 Concrete tile 9 ABS 11 Other (specify)  
 12 None used (open hole)

SCREEN OR PERFORATION OPENINGS ARE:  
 1 Continuous slot 3 Mill slot 5 Gauzed wrapped 8 Saw cut 11 None (open hole)  
 2 Louvered shutter 4 Key punched 6 Wire wrapped 9 Drilled holes  
 7 Torch cut 10 Other (specify)

SCREEN-PERFORATED INTERVALS: From 102 ft. to 122 ft., From ..... ft. to ..... ft.  
 From ..... ft. to ..... ft., From ..... ft. to ..... ft.

GRAVEL PACK INTERVALS: From 90 ft. to 122 ft., From ..... ft. to ..... ft.  
 From ..... ft. to ..... ft., From ..... ft. to ..... ft.

GROUT MATERIAL: 1 Neat cement 2 Cement grout 3 Bentonite 4 Other Drill cuttings  
 Grout intervals: From 15 ft. to 90 ft., From 4 ft. to 15 ft., From ..... ft. to ..... ft.

What is the nearest source of possible contamination:  
 1 Septic tank 4 Lateral lines 7 Pit privy 10 Livestock pens 14 Abandoned water well  
 2 Sewer lines 5 Cess pool 8 Sewage lagoon 11 Fuel storage 15 Oil well/Gas well  
 3 Watertight sewer lines 6 Seepage pit 9 Feedyard 12 Fertilizer storage 16 Other (specify below)  
 13 Insecticide storage  
 Direction from well? East How many feet? 200

FROM	TO	LITHOLOGIC LOG	FROM	TO	LITHOLOGIC LOG
0	24	Clay	24	37	Caliche
37	74	Sand cemented	74	77	Sand
77	84	Sand cemented	84	98	Sand
98	99	Sand cemented	99	104	Fine sand
104	107	Sand rock	107	114	Clay
114	120	Sand	120	122	Yellow clay
122		Shale			

CONTRACTOR'S OR LANDOWNER'S CERTIFICATION: This water well was (1) constructed, (2) reconstructed, or (3) plugged under my jurisdiction and was completed on (mo/day/year) 5/29/95 and this record is true to the best of my knowledge and belief. Kansas Water Well Contractor's License No. 232. This Water Well Record was completed on (mo/day/yr) 5/31/95 by (signature) [Signature]  
 Under the business name of Weishaar Drilling & Supply Inc.

INSTRUCTIONS: Use typewriter or ball point pen, PLEASE PRESS FIRMLY and PRINT clearly. Please fill in blanks, underline or circle the correct answers. Send top three copies to Kansas Department of Health and Environment, Division of Environment, Environmental Geology Section, Topeka, KS 66620. Send one to WATER WELL OWNER and retain one for your records.