

CORRECTION(S) TO WATER WELL RECORD (WWC-5)
(to rectify lacking or incorrect information)

County: Lane

Location listed as:

Section-Township-Range: 30-16-28 W

Fraction ($\frac{1}{4}$ $\frac{1}{4}$ $\frac{1}{4}$): SW SW SW SW

Location changed to:

30-16-5-28 W

SW SW SW SW

Other changes: Initial statements: Lat.: 38.62840 , Long: 100.57560

Changed to: Lat.: N 38.6275°, Long.: -100.4683

Comments: _____

verification method: Written & legal descriptions, description of nearest source of possible contamination, aerial photos & lat./longs. on Google Earth, & mapping tool on KGS website. initials: ERL date: 7/22/2010


submitted by: Kansas Geological Survey, Data Resources Library, 1930 Constant Ave., Lawrence, KS 66047-3726
to: Kansas Dept of Health & Environment, Bureau of Water, 1000 SW Jackson, Suite 420, Topeka, KS 66612-1367.

1 LOCATION OF WATER WELL: Fraction SW 1/4 SW 1/4 SW 1/4 Section Number 30 Township Number 16 Range Number 28 E/W

Distance and direction from nearest town or city street address of well if located within city?

1 MILE North on Karl Rd. FROM Jct of Hwy #4 & #23

2 WATER WELL OWNER: ALAN JAMES Global Positioning Systems (decimal degrees, min. of 4 digits)
 RR#, St. Address, Box #: 251 N Karl Road Latitude: 38.62840°
 City, State ZIP Code: Dighton, Ks 67839 Longitude: 100.57560°
 Elevation: _____ Datum: _____
 Data Collection Method: _____

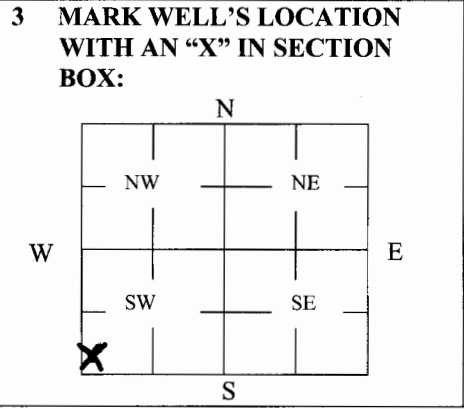

4 DEPTH OF WELL 112 ft.
 WELL'S STATIC WATER LEVEL 95' 6" ft.
 WELL WAS USED AS:
 Domestic 5 Public Water Supply 9 Dewatering
 2 Irrigation 6 Oil Field Water Supply 10 Monitoring
 3 Feedlot 7 Domestic (Lawn & Garden) 11 Injection Well
 4 Industrial 8 Air Conditioning 12 Other _____
 Was a chemical/bacteriological sample submitted to Department? Yes No _____

5 TYPE OF BLANK CASING USED:
 Steel 3 RMP (SR) 5 Wrought 7 Fiberglass 9 Other (Specify below)
 PVC 4 ABS 6 Asbestos-Cement 8 Concrete Tile
 Blank casing diameter 5" in. Was casing pulled? Yes _____ No If yes, how much 5 1/2 FT.
 Casing height above or below land surface 5 FT 6 in.

6 GROUT PLUG MATERIAL: 1 Neat cement 2 Cement grout Bentonite 4 Other _____
 Grout Plug Intervals: From 93 ft. to 88 ft., From 10 1/2 ft. to 5 1/2 ft., From _____ to _____ ft.
 What is the nearest source of possible contamination:
 1 Septic tank 6 Seepage pit 11 Fuel Storage 16 Other (specify below) _____
 2 Sewer lines 7 Pit privy 12 Fertilizer storage _____
 3 Watertight sewer lines 8 Sewage lagoon 13 Insecticide storage _____
 4 Lateral lines 9 Feedyard 14 Abandoned water well Direction from well? East & South East
 5 Cess pool 10 Livestock pens 15 Oil well/Gas well How many feet? 80 FT

FROM	TO	PLUGGING MATERIALS	FROM	TO	PLUGGING MATERIALS
112'	93'	Clean SAND			
93'	88'	Bentonite chips			
88'	10 1/2'	Clean subsoil dirt			
10 1/2'	5 1/2'	Bentonite chips			
5 1/2'	0'	Clean subsoil			

7 CONTRACTOR'S OR LANDOWNER'S CERTIFICATION: This water well was plugged under my jurisdiction and was completed on (mo/day/year) 1/26/19 and this record is true to the best of my knowledge and belief. Kansas Water Well Contractor's License No. _____. This Water Well Record was completed on (mo/day/year) 1/26/19 under the business name of Well owner by (signature) Alan James

INSTRUCTIONS: Use typewriter or ballpoint pen. Please press firmly and print clearly. Please fill in blanks, underline or circle the correct answers. Send top three copies to Kansas Department of Health and Environment, Bureau of Water, Geology Section, 1000 SW Jackson St., Ste. 420, Topeka, Kansas 66612-1367. Telephone: 785/296-5522. Send one to Water Well Owner and retain one for your records. Visit us at <http://www.kdheks.gov/geo/waterwells>.