

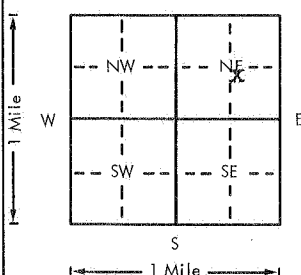
USE TYPEWRITER OR BALL POINT PEN-PRESS FIRMLY, PRINT CLEARLY.

# CHEYENNE CREEK

WATER WELL RECORD  
KSA 82a-1201-1215

Kansas Department of Health and Environment-Division of Environment (Water well Contractors) Topeka, Kansas 66620

ADB

1. Location of well:		County <b>Lane</b>	Fraction <b>N/W 1/4 S/E 1/4 N/E 1/4</b>	Section number <b>20</b>	Township number <b>T 16 S R 29 #W</b>	Range number
2. Distance and direction from nearest town or city: <b>4 E., 4 N. of Healy, Kansas</b> Street address of well location if in city:				3. Owner of well: <b>Dean Hamilton</b> R.R. or street: <b>Healy, Kansas 67850</b> City, state, zip code:		
4. Locate with "X" in section below: Sketch map: 				6. Bore hole dia. <u>9</u> in. Completion date _____ Well depth <u>35</u> ft. <u>12-14-1978</u>		
5. Type and color of material				7. <input checked="" type="checkbox"/> Cable tool <input checked="" type="checkbox"/> Rotary <input type="checkbox"/> Driven <input type="checkbox"/> Dug <input type="checkbox"/> Hollow rod <input type="checkbox"/> Jetted <input type="checkbox"/> Bored <input type="checkbox"/> Reverse rotary		
				8. Use: <input checked="" type="checkbox"/> Domestic <input type="checkbox"/> Public supply <input type="checkbox"/> Industry <input type="checkbox"/> Irrigation <input type="checkbox"/> Air conditioning <input type="checkbox"/> Stock <input type="checkbox"/> Lawn <input type="checkbox"/> Oil field water <input type="checkbox"/> Other		
				9. Casing: Material <u>Plastic</u> Height: Above or below Threaded _____ Welded <u>glue</u> Surface <u>12</u> in. RMP <input checked="" type="checkbox"/> PVC _____ Weight <u>1.8</u> lbs./ft. Dia. <u>5</u> in. to <u>25</u> ft. depth Wall Thickness: inches or Dia. _____ in. to _____ ft. depth gage No. <u>250</u>		
				10. Screen: Manufacturer's name _____ <u>Jess &amp; Lowell</u> Type <u>RMP</u> Dia. <u>5"</u> Slot/gauze <u>1/16"</u> Length <u>10'</u> Set between <u>25</u> ft. and <u>35</u> ft. _____ ft. and _____ ft. Gravel pack? <u>yes</u> Size range of material <u>1/4" x 1/8"</u>		
				11. Static water level: _____ mo./day/yr. <u>25</u> ft. below land surface Date <u>12-13-78</u>		
				12. Pumping level below land surfaces: <u>30</u> ft. after <u>2</u> hrs. pumping <u>10</u> g.p.m. _____ ft. after _____ hrs. pumping _____ g.p.m. Estimated maximum yield _____ g.p.m.		
				13. Water sample submitted: _____ mo./day/yr. <input type="checkbox"/> Yes <input checked="" type="checkbox"/> No Date _____		
				14. Well head completion: <input checked="" type="checkbox"/> Pitless adapter <u>12</u> Inches above grade		
				15. Well grouted? <u>yes</u> With: <input checked="" type="checkbox"/> Neat cement <input type="checkbox"/> Bentonite <input type="checkbox"/> Concrete Depth: From <u>0</u> ft. to <u>15</u> ft.		
				16. Nearest source of possible contamination: ft. <u>100</u> Direction <u>East</u> Type <u>Septic</u> Well disinfected upon completion? <input checked="" type="checkbox"/> Yes <input type="checkbox"/> No		
				17. Pump: _____ Not installed Manufacturer's name <u>Peerless</u> Model number _____ HP <u>1/2</u> Volts <u>110</u> Length of drop pipe <u>30</u> ft. capacity <u>10</u> g.p.m. Type: <input checked="" type="checkbox"/> Submersible <input type="checkbox"/> Turbine <input type="checkbox"/> Jet <input type="checkbox"/> Reciprocating <input type="checkbox"/> Centrifugal <input type="checkbox"/> Other		
				20. Water well contractor's certification: This well was drilled under my jurisdiction and this report is true to the best of my knowledge and belief. <u>Weishaar Drilling &amp; Sup. 232</u> Business name License No. Address <u>Scott City, KS 67871</u> Signed: <u>Raymond [Signature]</u> Date <u>12/81</u> Authorized representative		
18. Elevation:		19. Remarks: <u>2718 (TOPO)</u>				
Topography: <input type="checkbox"/> Hill <input checked="" type="checkbox"/> Slope <input type="checkbox"/> Upland <input type="checkbox"/> Valley						

Forward the white, blue and pink copies to the Department of Health and Environment

Form WWC-5