

1	LOCATION OF WATER WELL:	Fraction	Section Number	Township Number	Range Number
County:	Saline	NE $\frac{1}{4}$ SE $\frac{1}{4}$ NW $\frac{1}{4}$	12	T 16 S	R 3 EW

Distance and direction from nearest town or city street address of well if located within city?


300 S. Railroad Assaria, Ks.

2 WATER WELL OWNER: Gary Clarkson
RR#, St. Address, Box # : 300 S. Railroad
City, State, ZIP Code : Assaria KS

Board of Agriculture, Division of Water Resources
Application Number:

3	LOCATE WELL'S LOCATION WITH	4	DEPTH OF COMPLETED WELL <u>63.8</u>
---	-----------------------------	---	-------------------------------------

AN "X" IN SECTION BOX:

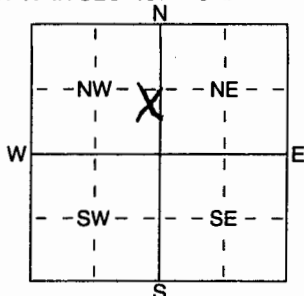

4 DEPTH OF COMPLETED WELL 65.8 ft. ELEVATION: _____
 Depth(s) Groundwater Encountered 1 _____ ft 2 _____ ft 3 _____ ft

Depth(s) Groundwater Encountered 1 ft. 2 ft. 3 ft.
WELL'S STATIC WATER LEVEL 24.7 ft. below land surface measured on mo/day/yr 12/18/02
Pump test data: Well water was ft. after hours pumping gpm
Est. Yield 30 gpm: Well water was ft. after hours pumping gpm
WELL WATER TO BE USED AS:
1 Domestic 3 Feedlot 5 Public water supply 8 Air conditioning 11 Injection well
2 Irrigation 4 Industrial 6 Oil field water supply 9 Dewatering 12 Other (Specify below)
7 Domestic (lawn & garden) 10 Monitoring well

Was a chemical/bacteriological sample submitted to Department? Yes No; If yes, mo/day/hrs sample was submitted
Water Well Disinfected? Yes No

5	TYPE OF BLANK CASING USED:
---	----------------------------

1 Steel
2 PVC
3 RMP (SR)
4 ABS

5 Wrought iron
6 Asbestos-Cement
7 Fiberglass

8 Concrete tile
9 Other (specify below)

CASING JOINTS: Glued ☒ Clamped
Welded
Threaded

Blank casing diameter 5 in. to 48.8 ft. Dia _____ in. to _____ ft. Dia _____ in. to _____ ft.

Casing height above land surface 18 in., weight SCH 40 lbs./ft. Wall thickness or gauge No.

TYPE OF SCREEN OR PERFORATION MATERIAL:

1 Steel	3 Stainless Steel
2 Brass	4 Galvanized Steel

5 Fiberglass
6 Concrete tile

7 PVC
8 RMP (SR)
9 ABS

10 Asbestos-Cement
11 Other (Specify)
12 None used (open hole)

SCREEN OR PERFORATION OPENINGS ARE:

1 Continuous slot 3 Mill slot
2 Louvered shutter 4 Key punched

5 Guazed wrapped
6 Wire wrapped
7 Torch cut

8 Saw cut
9 Drilled holes
10 Other (specify)
11 None (open hole)

SCREEN-PERFORATED INTERVALS: From 63.8 ft. to 48.0 ft., From _____ ft. to _____ ft.

From ft. to ft., From ft. to ft.

GRAVEL PACK INTERVALS: From 70 ft. to 21 ft., From _____ ft. to _____ ft.

From ft. to ft., From ft. to ft.

6 GROUT MATERIAL: 1 Neat cement 2 Cement grout 3 Bentonite 4 Other

Grout Intervals: From 21 ft. to 0 ft., From _____ ft. to _____ ft., From _____ ft. to _____ ft.

What is the nearest source of possible contamination:

1 Septic tank	4 Lateral lines
2 Sewer lines	5 Cess pool
3 Watertight sewer lines	6 Seepage pit

7 Pit privy
8 Sewage lagoon
9 Feedyard

10 Livestock pens	14 Abandoned water well
11 Fuel storage	15 Oil well/Gas well
12 Fertilizer storage	16 Other (specify below)
13 Insecticide storage

Direction from well?

How many feet? 50 +

[illegible]

7 CONTRACTOR'S OR LANDOWNER'S CERTIFICATION: This water well was (1) constructed, (2) reconstructed, or (3) plugged under my jurisdiction and was completed on (mo/day/year) 12/18/02 and this record is true to the best of my knowledge and belief. Kansas

Water Well Contractor's Licence No. 11527 This Water Well Record was completed on (mo/day/yr) 11/10/03
under the business name of Geolore Inc by (signature) Dale Bell