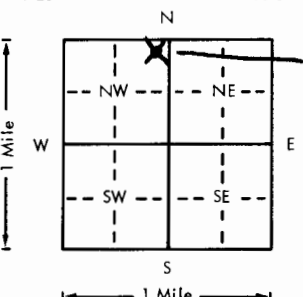


USE TYPEWRITER OR BALL
POINT PEN-PRESS FIRMLY,
PRINT CLEARLY.

WATER WELL RECORD
KSA 82a-1201-1215

Kansas Department of Health and
Environment-Division of Environment
(Water well Contractors)
Topeka, Kansas 66620

1. Location of well:	County SALINE	Fraction NE 1/4 NE 1/4 NW 1/4	Section number 10	Township number T 16 S R 3	Range number 3
2. Distance and direction from nearest town or city: Street address of well location if in city:	1 1/2 mi. WEST OF ASSARIA, Ks		3. Owner of well: R.R. or street: City, state, zip code: Merle Swanson 1508 Parkway Salina, Ks. 67401		
4. Locate with "X" in section below: Sketch map:			6. Bore hole dia. 8 in. Completion date Well depth 60 ft. 11-2-78		
5. Type and color of material	From	To	7. <input checked="" type="checkbox"/> Cable tool <input checked="" type="checkbox"/> Rotary <input type="checkbox"/> Driven <input type="checkbox"/> Dug <input type="checkbox"/> Hollow rod <input type="checkbox"/> Jetted <input type="checkbox"/> Bored <input type="checkbox"/> Reverse rotary		
Top soil	0	5	8. Use: <input checked="" type="checkbox"/> Domestic <input type="checkbox"/> Public supply <input type="checkbox"/> Industry <input type="checkbox"/> Irrigation <input type="checkbox"/> Air conditioning <input type="checkbox"/> Stock <input type="checkbox"/> Lawn <input type="checkbox"/> Oil field water <input type="checkbox"/> Other		
Clay + gravel	5	15	9. Casing: Material <input type="checkbox"/> Height: Above or below Threaded <input type="checkbox"/> Welded <input type="checkbox"/> Surface 12 in. RMP <input type="checkbox"/> PVC <input checked="" type="checkbox"/> Weight 2 lbs./ft.		
Creek gravel	15	20	Dia. 4 in. to 20 ft. depth Wall Thickness: inches or Dia. <input type="checkbox"/> in. to <input type="checkbox"/> ft. depth gage No. 25		
Loose blue clay	20	25	10. Screen: Manufacturer's name Peerless Plastics		
Red shale	25	40	Type PVC Dia. 4" Slot/gauze 1/16 Length 40'		
Hard red shale	40	45	Set between 20 ft. and 60 ft. ft. and <input type="checkbox"/> ft.		
Soft layers red shale	45	55	Grovel pack? Yes Size range of material 1/4		
Hard red shale	55	60	11. Static water level: <input type="checkbox"/> mo./day/yr. 18 ft. below land surface Date 11/2/78		
			12. Pumping level below land surfaces: 40 ft. after 1 hrs. pumping 6 g.p.m. ft. after <input type="checkbox"/> hrs. pumping <input type="checkbox"/> g.p.m. Estimated maximum yield 6 g.p.m.		
			13. Water sample submitted: <input type="checkbox"/> Yes <input checked="" type="checkbox"/> No Date <input type="checkbox"/> mo./day/yr.		
			14. Well head completion: <input type="checkbox"/> Pitless adapter 12 Inches above grade		
			15. Well grouted? Yes With: <input checked="" type="checkbox"/> Neat cement <input type="checkbox"/> Bentonite <input type="checkbox"/> Concrete Depth: From 4 ft. to 14 ft.		
			16. Nearest source of possible contamination: PEPPERED ft. 100 Direction South Type SEWER Well disinfected upon completion? <input checked="" type="checkbox"/> Yes <input type="checkbox"/> No		
			17. Pump: <input checked="" type="checkbox"/> Not installed Manufacturer's name <input type="checkbox"/> Model number <input type="checkbox"/> HP <input type="checkbox"/> Volts <input type="checkbox"/> Length of drop pipe <input type="checkbox"/> ft. capacity <input type="checkbox"/> g.p.m. Type: <input type="checkbox"/> Submersible <input type="checkbox"/> Turbine <input type="checkbox"/> Jet <input type="checkbox"/> Reciprocating <input type="checkbox"/> Centrifugal <input type="checkbox"/> Other		
18. Elevation:	19. Remarks:		20. Water well contractor's certification: This well was drilled under my jurisdiction and this report is true to the best of my knowledge and belief. PETERSON IRRIGATION 138 Business name License No. Address Box 150 LINDSBURG, KS Signed Mike Peterson Date 11-17-78 Authorized representative		

Forward the white, blue and pink copies to the Department of Health and Environment

Form WWC-5