


WATER WELL RECORD Form WWC-5 KSA 82a-1212

Distance and direction from nearest town or city street address of well if located within city?

2 WATER WELL OWNER: Debra Billings

3 LOCATE WELL'S LOCATION WITH 4 DEPTH OF COMPLETED WELL... 59... ft. ELEVATION: 1100

WELL'S STATIC WATER LEVEL 23 ft. below land surface measured on mo/day/yr 4-12-88

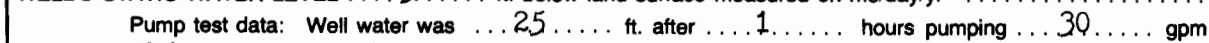

Est. Yield .. 75+ ... gpm; Well water was ..... ft. after ..... hours pumping ..... gpm

Bore Hole Diameter . . .  $8\frac{1}{2}$  . . . in. to . . . 59 . . . ft., and . . . in. to . . . ft.

**WELL WATER TO BE USED AS:**      5 Public water supply      8 Air conditioning      11 Injection well

<u>1 Domestic</u>	3 Feedlot	6 Oil field water supply	9 Dewatering	12 Other (Specify below)
-------------------	-----------	--------------------------	--------------	--------------------------

2 Irrigation      4 Industrial      7 Lawn and garden only      10 Observation well

Was a chemical/bacteriological sample submitted to Department? Yes.....No...X.....; If yes, mo/day/yr sample was sub

mitted	Water Well Disinfected?	Yes	X	No
--------	-------------------------	-----	---	----

1 Steel                      3 RMP (SR)                      6 Asbestos-Cement                      9 Other (specify below)                      Welded .....

Blank casing diameter . . . 5 . . . . . in. to . . . 52 . . . . . ft., Dia . . . . . in. to . . . . . ft., Dia . . . . . in. to . . . . . 'ft.

TYPE OF SCREEN OR PERFORATION MATERIAL: 7 PVC 10 Asbestos-cement

2 Brass      4 Galvanized steel      6 Concrete tile      9 ABS      12 None used (open hole)

1 Continuous slot      3 Mill slot      6 Wire wrapped      9 Drilled holes

SCREEN-PERFORATED INTERVALS: From 52 ft. to 59 ft., From \_\_\_\_\_ ft. to \_\_\_\_\_ ft.

GRAVEL PACK INTERVALS: From, none . . . . . ft. to . . . . . ft., From . . . . . ft. to . . . . . ft.

6. GROUT MATERIAL: 1 Neat cement      2 Cement grout      3 Bentonite      4 Other .....

What is the nearest source of possible contamination: 10 Livestock pens 14 Abandoned water well

2 Sewer lines      5 Cess pool      8 Sewage lagoon      12 Fertilizer storage      16 Other (specify below)

Direction from well? East How many feet? 60

1	3	Top Soil			
---	---	----------	--	--	--

23	45	Sand			
----	----	------	--	--	--

46	59	Med. Sand & Gravel			
----	----	--------------------	--	--	--

[illegible][illegible][illegible][illegible][illegible]

completed on (mo/day/year) 4-12-88 and this record is true to the best of my knowledge and belief. Kansas

under the business name of Pestinger Pump Service by (signature) [Signature]

Department of Health and Environment, Bureau of Water Protection, Topeka, Kansas 66620-7320, Telephone: 913-862-9360. Send one to WATER WELL OWNER and retain one for your