


1 LOCATION OF WATER WELL:	Fraction	Section Number	Township Number	Range Number
County: <b>Lane</b>	<b>SW ¼ SW ¼ NW ¼</b>	<b>28</b>	<b>16s</b>	<b>30w</b>

Distance and direction from nearest town or city street address of well if located within city?

2 WATER WELL OWNER: **Betty Sharp**  
 RR#, St. Address, Box # **552 Lakewood Circle**  
 City, State, ZIP Code : **Colorado Springs, CO 80910**  
 Board of Agriculture, Division of Water Resources  
 Application Number: **20070179**

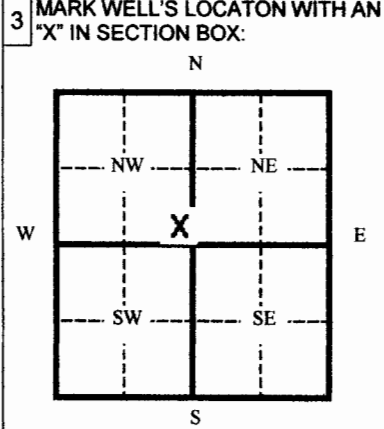

4 DEPTH OF WELL **200** ft.  
 WELL'S STATIC WATER LEVEL **165** ft.  
 WELL WAS USED AS:  
 1 Domestic                      5 Public Water Supply                      9 Dewatering  
 2 Irrigation                      6 Oil Field Water Supply                      10 Monitoring Well  
 3 Feedlot                          7 Lawn and Garden (domestic)                      11 Injection Well  
 4 Industrial                      8 Air Conditioning                          12 Other \_\_\_\_\_

Was a chemical/bacteriological sample submitted to Department? Yes \_\_\_\_\_ No **X**  
 If yes, mo/day/yr sample was submitted \_\_\_\_\_  
 Water Well Disinfected: Yes \_\_\_\_\_ No **X**

5 TYPE OF BLANK CASING USED:  
 1 Steel                      3 RMP (SR)                      5 Wrought                      7 Fiberglass                      9 Other (specify below)  
 2 PVC                      4 ABC                          6 Asbestos-Cement                      8 Concrete Tile

Blank casing diameter **4.5** in. Was casing pulled? Yes \_\_\_\_\_ No **X** If yes, how much \_\_\_\_\_  
 Casing height above or below land surface **-3** in.

6 GROUT PLUG MATERIAL: 1 Neat cement    2 Cement grout    3 **Bentonite**    4 Other \_\_\_\_\_

Grout Plug Intervals From **3** ft. to **0** ft. From \_\_\_\_\_ ft. to \_\_\_\_\_ ft. From \_\_\_\_\_ ft. to \_\_\_\_\_ ft.

What is the nearest source of possible contamination:  
 1 Septic tank                      6 Seepage pit                      11 Fuel storage                      16 Other (specify below)  
 2 Sewer lines                      7 Pit privy                          12 Fertilizer storage                      **None**  
 3 Watertight sewer lines                      8 Sewage lagoon                      13 Insecticide storage  
 4 Lateral lines                      9 Feedyard                          14 Abandoned water well  
 5 Cess Pool                          10 Livestock pens                      15 Oil well/ Gas well

Direction from well? \_\_\_\_\_ How many feet? \_\_\_\_\_

FROM	TO	CODE	PLUGGING MATERIALS
<b>200</b>	<b>165</b>		<b>Sand</b>
<b>165</b>	<b>3</b>		<b>Compacted Soil</b>
<b>3</b>	<b>0</b>		<b>Bentonite</b>

7 CONTRACTOR'S OR LANDOWNER'S CERTIFICATION: This water well was plugged under my jurisdiction and was completed on (mo/day/yr) **10-18-07** and this record is true to the best of my knowledge and belief. Kansas Water Well Contractor's License No. **554** This Water Well Record was completed on (mo/day/yr) **10-22-07** under the business name of **Woofter Pump & Well Inc.**  
 by (signature) *[Signature]*

INSTRUCTIONS: Please fill in blanks and circle the correct answers. Send three copies to Kansas Department of Health and Environment, Bureau of Water, 1000 S W Jackson St., Ste. 420, Topeka, Kansas 66620-0001. Telephone: 785-296-3565. Send one to Water Well Owner and retain one for your records.