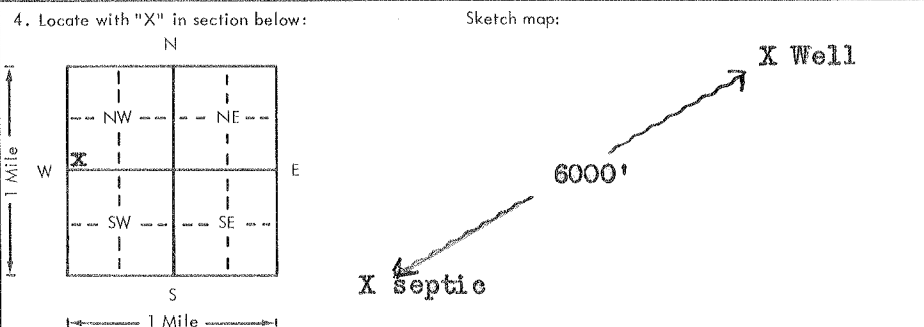
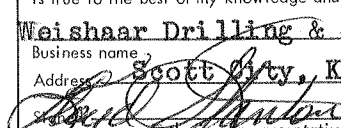


USE TYPEWRITER OR BALL POINT PEN—PRESS FIRMLY, PRINT CLEARLY.

WATER WELL RECORD
KSA 82a-1201-1215

Kansas Department of Health and Environment—Division of Environment (Water well Contractors)
Topeka, Kansas 66620

1. Location of well:		County Scott	Fraction S/W 1/4 S/W 1/4 N/W 1/4	Section number 10	Township number T 16 S R	Range number 31 #E/W
2. Distance and direction from nearest town or city: 9 E., 13 1/2 N. of Scott City, Kansas Street address of well location if in city:				3. Owner of well: Jack Jewell R.R. or street: Scott City, Kansas 67871 City, state, zip code:		
4. Locate with "X" in section below: Sketch map: 				6. Bore hole dia. <u>9</u> in. Completion date _____ Well depth <u>140</u> ft. <u>6-2-1978</u>		
5. Type and color of material				7. <input type="checkbox"/> Cable tool <input checked="" type="checkbox"/> Rotary <input type="checkbox"/> Driven <input type="checkbox"/> Dug <input type="checkbox"/> Hollow rod <input type="checkbox"/> Jetted <input type="checkbox"/> Bored <input type="checkbox"/> Reverse rotary		
				8. Use: <input type="checkbox"/> Domestic <input type="checkbox"/> Public supply <input type="checkbox"/> Industry <input type="checkbox"/> Irrigation <input type="checkbox"/> Air conditioning <input checked="" type="checkbox"/> Stock <input type="checkbox"/> Lawn <input type="checkbox"/> Oil field water <input type="checkbox"/> Other		
				9. Casing: Material <u>Plastic</u> Height: Above or below Threaded _____ Welded <u>glue</u> Surface <u>12</u> in. RMP <input checked="" type="checkbox"/> PVC _____ Weight <u>1.8</u> lbs./ft. Dia. <u>5</u> in. to <u>120</u> ft. depth Wall Thickness: inches or Dia. _____ in. to _____ ft. depth gage No. <u>.250</u>		
				10. Screen: Manufacturer's name <u>Jess & Lowell</u> Type <u>RMP</u> Dia. <u>5"</u> Slot/gauze <u>1/16"</u> Length <u>20'</u> Set between <u>120</u> ft. and <u>140</u> ft. _____ ft. and _____ ft. Gravel pack? <u>yes</u> Size range of material <u>1/4 X 1/8"</u>		
				11. Static water level: _____ mo./day/yr. <u>127</u> ft. below land surface Date <u>6-1-1978</u>		
				12. Pumping level below land surfaces: <u>130</u> ft. after <u>1</u> hrs. pumping <u>4</u> g.p.m. _____ ft. after _____ hrs. pumping _____ g.p.m. Estimated maximum yield _____ g.p.m.		
				13. Water sample submitted: _____ mo./day/yr. <input type="checkbox"/> Yes <input checked="" type="checkbox"/> No Date _____		
				14. Well head completion: <input type="checkbox"/> Pitless adapter <u>12</u> Inches above grade		
				15. Well grouted? <u>yes</u> With: <input checked="" type="checkbox"/> Neat cement _____ Bentonite _____ Concrete _____ Depth: From <u>0</u> ft. to <u>15</u> ft.		
				16. Nearest source of possible contamination: ft. <u>6000</u> Direction <u>S/W</u> Type <u>septic</u> Well disinfected upon completion? <input checked="" type="checkbox"/> Yes _____ No		
				17. Pump: _____ Not installed Manufacturer's name <u>Aermotor windmill</u> Model number _____ HP _____ Volts _____ Length of drop pipe <u>135</u> ft. capacity <u>4</u> g.p.m. Type: <input type="checkbox"/> Submersible _____ Turbine _____ <input type="checkbox"/> Jet _____ Reciprocating _____ <input type="checkbox"/> Centrifugal <u>cylinder</u> Other _____		
(Use a second sheet if needed)						
18. Elevation:		19. Remarks:				
Topography: <input type="checkbox"/> Hill <input type="checkbox"/> Slope <input checked="" type="checkbox"/> Upland <input type="checkbox"/> Valley		20. Water well contractor's certification: This well was drilled under my jurisdiction and this report is true to the best of my knowledge and belief. <u>Weishaar Drilling & Sup. 232</u> Business name License No. _____ Address <u>Scott City, KS 67871</u>  Date <u>6/14/78</u> Authorized Representative				

Forward the white, blue and pink copies to the Department of Health and Environment

Form WWC-5