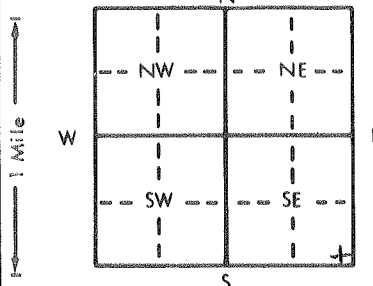


1 LOCATION OF WATER WELL: Fraction SE 1/4 SE 1/4 SE 1/4 Section Number 34 Township Number T 16 S Range Number R 31 EW
 County: Scott

Distance and direction from nearest town or city street address of well if located within city?
4 Miles North of Manning, Kansas

2 WATER WELL OWNER: Cornelia Thon
 RR#, St. Address, Box # : _____ Board of Agriculture, Division of Water Resources
 City, State, ZIP Code : Healy, Kansas 67850 Application Number: _____

3 LOCATE WELL'S LOCATION WITH AN "X" IN SECTION BOX:


4 DEPTH OF COMPLETED WELL: 122 ft. ELEVATION: _____
 Depth(s) Groundwater Encountered 1. 56 ft. 2. _____ ft. 3. _____ ft.
 WELL'S STATIC WATER LEVEL 56 ft. below land surface measured on mo/day/yr 10-14-87
 NA Pump test data: Well water was _____ ft. after _____ hours pumping _____ gpm
 Est. Yield _____ gpm: Well water was _____ ft. after _____ hours pumping _____ gpm
 Bore Hole Diameter. 9 in. to 122 ft., and _____ in. to _____ ft.
 WELL WATER TO BE USED AS: 5 Public water supply 8 Air conditioning 11 Injection well
 Domestic 3 Feedlot 6 Oil field water supply 9 Dewatering 12 Other (Specify below)
 2 Irrigation 4 Industrial 7 Lawn and garden only 10 Observation well
 Was a chemical/bacteriological sample submitted to Department? Yes _____ No X; If yes, mo/day/yr sample was submitted _____
 Water Well Disinfected? Yes X No

5 TYPE OF BLANK CASING USED: 5 Wrought iron 8 Concrete tile CASING JOINTS: Glued _____ Clamped _____
 1 Steel 3 RMP (SR) 6 Asbestos-Cement 9 Other (specify below) Welded _____
 PVC 4 ABS 7 Fiberglass _____ Threaded _____
 Blank casing diameter 5 in. to 102 ft., Dia _____ in. to _____ ft., Dia _____ in. to _____ ft.
 Casing height above land surface 12 in., weight 2.765 lbs./ft. Wall thickness or gauge No. 258
 TYPE OF SCREEN OR PERFORATION MATERIAL: PVC 10 Asbestos-cement
 1 Steel 3 Stainless steel 5 Fiberglass 8 RMP (SR) 11 Other (specify) _____
 2 Brass 4 Galvanized steel 6 Concrete tile 9 ABS 12 None used (open hole)
 SCREEN OR PERFORATION OPENINGS ARE: 5 Gauzed wrapped Saw cut 11 None (open hole)
 1 Continuous slot 3 Mill slot 6 Wire wrapped 9 Drilled holes
 2 Louvered shutter 4 Key punched 7 Torch cut 10 Other (specify) _____
 SCREEN-PERFORATED INTERVALS: From 102 ft. to 122 ft., From _____ ft. to _____ ft.
 From _____ ft. to _____ ft., From _____ ft. to _____ ft.
 GRAVEL PACK INTERVALS: From 50 ft. to 122 ft., From _____ ft. to _____ ft.
 From _____ ft. to _____ ft., From _____ ft. to _____ ft.

6 GROUT MATERIAL: Neat cement 2 Cement grout 3 Bentonite Other Drill Cuttings
 Grout Intervals: From 25 ft. to 50 ft., From 4 ft. to 25 ft., From _____ ft. to _____ ft.
 What is the nearest source of possible contamination:
 Septic tank 4 Lateral lines 7 Pit privy 10 Livestock pens 14 Abandoned water well
 2 Sewer lines 5 Cess pool 8 Sewage lagoon 11 Fuel storage 15 Oil well/Gas well
 3 Watertight sewer lines 6 Seepage pit 9 Feedyard 12 Fertilizer storage 16 Other (specify below)
 13 Insecticide storage
 Direction from well? East How many feet? 100

FROM	TO	LITHOLOGIC LOG	FROM	TO	LITHOLOGIC LOG
0	7	Clay	7	13	Caliche sand streaks
13	37	Sand Medium	37	63	Fine sand
63	87	Fine sand clay streaks	87	89	Sand cemented
89	93	Fine sand clay streaks	93	103	Sand
103	104	Sand cemented	104	108	Sand clay streaks
108	114	Fine sand clay streaks	114	120	Sand
120	122	Yellow Clay	122		Shale

7 CONTRACTOR'S OR LANDOWNER'S CERTIFICATION: This water well was constructed, reconstructed, or plugged under my jurisdiction and was completed on (mo/day/year) 10-15-87 and this record is true to the best of my knowledge and belief. Kansas Water Well Contractor's License No. 232 This Water Well Record was completed on (mo/day/yr) 10-15-87 under the business name of Weishaar Drilling & Supply Inc. by (signature) [Signature]