


1 LOCATION OF WATER WELL: Fraction NW 1/4 NE 1/4 NW 1/4 Section Number 35 Township Number T 16 S Range Number R 31 EW
 County: Scott

Distance and direction from nearest town or city street address of well if located within city?
5 miles North 1/4 mile East of Manning, Kansas

2 WATER WELL OWNER: Clifford Thon Board of Agriculture, Division of Water Resources
 RR#, St. Address, Box #: R R Application Number:
 City, State, ZIP Code: Healy, Kansas 67850

3 LOCATE WELL'S LOCATION WITH AN "X" IN SECTION BOX:

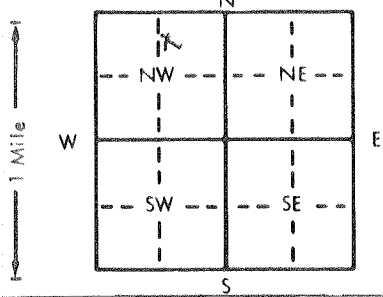

4 DEPTH OF COMPLETED WELL 102 ft. ELEVATION:
 Depth(s) Groundwater Encountered 1. 33 ft. 2. ft. 3. ft.
 WELL'S STATIC WATER LEVEL 33 ft. below land surface measured on mo/day/yr 5/24/85
 NA Pump test data: Well water was ft. after hours pumping gpm
 Est. Yield gpm: Well water was ft. after hours pumping gpm
 Bore Hole Diameter 9 in. to 102 ft., and in. to ft.
 WELL WATER TO BE USED AS: 5 Public water supply 8 Air conditioning 11 Injection well
1 Domestic 3 Feedlot 6 Oil field water supply 9 Dewatering 12 Other (Specify below)
 2 Irrigation 4 Industrial 7 Lawn and garden only 10 Observation well Steel well
 Was a chemical/bacteriological sample submitted to Department? Yes.....No X.....; If yes, mo/day/yr sample was submitted
 Water Well Disinfected? Yes X No

5 TYPE OF BLANK CASING USED: 5 Wrought iron 8 Concrete tile CASING JOINTS: Glued Clamped
1 Steel 3 RMP (SR) 6 Asbestos-Cement 9 Other (specify below) Welded
2 PVC 4 ABS 7 Fiberglass Threaded
 Blank casing diameter 5 in. to 82 ft., Dia in. to ft., Dia in. to ft.
 Casing height above land surface 12 in., weight 2.9 lbs./ft. Wall thickness or gauge No. 265

TYPE OF SCREEN OR PERFORATION MATERIAL: 7 PVC 10 Asbestos-cement
 1 Steel 3 Stainless steel 5 Fiberglass 8 RMP (SR) 11 Other (specify)
 2 Brass 4 Galvanized steel 6 Concrete tile 9 ABS 12 None used (open hole)

SCREEN OR PERFORATION OPENINGS ARE: 5 Gauzed wrapped 8 Saw cut 11 None (open hole)
 1 Continuous slot 3 Mill slot 6 Wire wrapped 9 Drilled holes
 2 Louvered shutter 4 Key punched 7 Torch cut 10 Other (specify)

SCREEN-PERFORATED INTERVALS: From 82 ft. to 102 ft., From ft. to ft.
 From ft. to ft., From ft. to ft.
 GRAVEL PACK INTERVALS: From 50 ft. to 102 ft., From ft. to ft.
 From ft. to ft., From ft. to ft.

6 GROUT MATERIAL: 1 Neat cement 2 Cement grout 3 Bentonite 4 Other Drill cuttings
 Grout Intervals: From 15 ft. to 50 ft., From 4 ft. to 15 ft., From ft. to ft.
 What is the nearest source of possible contamination: 10 Livestock pens 14 Abandoned water well
 1 Septic tank 4 Lateral lines 7 Pit privy 11 Fuel storage 15 Oil well/Gas well
 2 Sewer lines 5 Cess pool 8 Sewage lagoon 12 Fertilizer storage 16 Other (specify below)
 3 Watertight sewer lines 6 Seepage pit 9 Feedyard 13 Insecticide storage

Direction from well? East How many feet? 100

FROM	TO	LITHOLOGIC LOG	FROM	TO	LITHOLOGIC LOG
0	20	Clay	20	39	Fine sand
39	41	Sand cemented	41	50	Fine sand clay streaks
50	59	Fine sand	59	62	Clay
62	63	Sand Cemented	63	70	Clay
70	90	Sand	90	95	Sandy clay
95	100	Sand	100	102	Yellow clay
102		Shale			

7 CONTRACTOR'S OR LANDOWNER'S CERTIFICATION: This water well was (1) constructed, (2) reconstructed, or (3) plugged under my jurisdiction and was completed on (mo/day/year) 5/24/85 and this record is true to the best of my knowledge and belief. Kansas Water Well Contractor's License No. 232 This Water Well Record was completed on (mo/day/yr) 5/28/85 under the business name of Weishaar Drilling & Supply Inc. by (signature) Clifford Thon

INSTRUCTIONS: Use typewriter or ball point pen, PLEASE PRESS FIRMLY and PRINT clearly. Please fill in blanks, underline or circle the correct answers. Send to three copies to Kansas Department of Health and Environment, Division of Environment, Environmental Geology Section, Topeka, KS 66620. Send one to WATER WELL OWNER and retain one for your records.