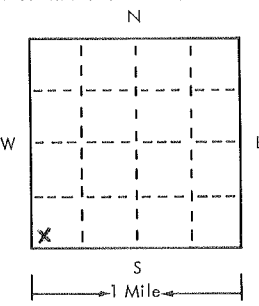


USE TYPEWRITER OR BALL POINT PEN—PRESS FIRMLY, PRINT CLEARLY.

T R EW sec 1/4 1/4 1/4 No.

WATER WELL RECORD
KSA 82a-1201-1215

Kansas State Dept. Of Health
(Water Well Contractors)
Forbes-Bldg. 740
Topeka, Kansas 66620

1 Location of well:	County Scott	Township name	Fraction SW$\frac{1}{4}$SW$\frac{1}{4}$SW$\frac{1}{4}$	Section number 36	Town number 16	Range number 31
Distance and direction from nearest town or city: 4W 1N 1W				3 Owner of well: Richard Graves		
Street address of well location if in city: of Healy, Kansas				Address: 26 S. Jordan Liberal, ks 67961		
Locate with "X" in section below: 				4 Well depth: 190 ft. Date of completion 8-4-76 Well diameter 12 in.		
				5 <input type="checkbox"/> Cable tool <input checked="" type="checkbox"/> Rotary <input type="checkbox"/> Driven <input type="checkbox"/> Dug <input type="checkbox"/> Hollow rod <input type="checkbox"/> Jetted <input type="checkbox"/> Bored <input type="checkbox"/> Reverse rotary		
				6 Use: <input type="checkbox"/> Domestic <input type="checkbox"/> Public supply <input type="checkbox"/> Industry <input checked="" type="checkbox"/> Irrigation <input type="checkbox"/> Air conditioning <input type="checkbox"/> Commercial <input type="checkbox"/> Test well <input type="checkbox"/>		
				7 Casing: Material Steel Height: above/below Threaded <input type="checkbox"/> Welded <input checked="" type="checkbox"/> Surface 12 in. Diam. 12 in. to 130 ft. depth Drive shoe? <input type="checkbox"/> Yes <input checked="" type="checkbox"/> No Weight 137 lbs./ft.		
				8 Screen: Manufacturer W.A. Brown Type Steel Dia. 12" Slot/gauze 10$\frac{3}{8}$ Length 60 Set between 130 ft. and 190 ft. Fittings: 1/2" - 1" Gravel pack <input checked="" type="checkbox"/> Yes <input type="checkbox"/> No Size range of material _____		
2 Type and color of material				9 Static water level: 110 ft. below land surface Date 8-4-76		
soil & clay				10 Pumping level below land surfaces: _____ ft. after _____ hrs. pumping _____ g.p.m. _____ ft. after _____ hrs. pumping _____ g.p.m. Estimated maximum yield 550 g.p.m.		
sand				11 Water sample submitted: <input type="checkbox"/> Yes <input checked="" type="checkbox"/> No Date _____		
Sandy clay				12 Well head completion: <input type="checkbox"/> Pitless adapter <input type="checkbox"/> Inches above grade		
clay				13 Well grouted? <input checked="" type="checkbox"/> Yes <input type="checkbox"/> No <input checked="" type="checkbox"/> Neat cement <input type="checkbox"/> Bentonite <input type="checkbox"/> Depth: From 0 ft. to 10 ft.		
sand				14 Nearest source of possible contamination: ft. _____ Direction _____ Type _____ Well disinfected upon completion? <input type="checkbox"/> Yes <input type="checkbox"/> No		
sandy clay				15 Pump: <input type="checkbox"/> Not installed Manufacturer's name Valley Model number DL60 HP 60 Volts NA Length of drop pipe 180 ft. capacity 500 g.m.p. Type: <input type="checkbox"/> Submersible <input checked="" type="checkbox"/> Turbine <input type="checkbox"/> Jet <input type="checkbox"/> Reciprocating <input type="checkbox"/> Centrifugal <input type="checkbox"/> Other		
fine sand						
sandy clay						
fine sand						
Yellow clay						
Blue Shale						
(use a second sheet if needed)						
16 Remarks: elevation				17 Water well contractor's certification: This well was drilled under my jurisdiction and this report is true to the best of my knowledge and belief. WINNERY DRILLING 256 Business name License No. _____ Address 425 Antelope Scott City, Ks. Signed [Signature] Date 7-30-80 Authorized representative		

16 3100 30 sec