USE TYPEWRITER OR BALL POINT PEN-PRESS FIRMLY, PRINT CLEARLY.

WATER WELL RECORD
KSA 82a-1201-1215

Kansas Department of Health and Environment-Division of Environment
(Water well Contractors)
Topeka, Kansas 66620

1. Location of well:	County	Fraction	Section number	Township number	Range number
	Scott	NE 1/4 NW 1/4 SW 1/4	19	T 16 S	R 33 E (W)

2. Distance and direction from nearest town or city: 12N, 6W, ½S, ¼E
Street address of well location if in city: of Scott City, KS

3. Owner of well: Roy Fairleigh
R.R. or street: Box 86 - RFD #3
City, state, zip code: Scott City, KS 67871

4. Locate with "X" in section below:

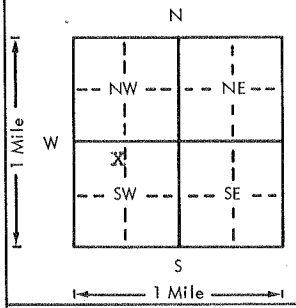

Sketch map:

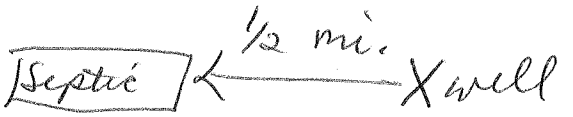

6. Bore hole dia. 26 in. Completion date 3-18-76
Well depth 200 ft.

7. __ Cable tool __ Rotary __ Driven __ Dug
__ Hollow rod __ Jetted __ Bored X Reverse rotary

8. Use: __ Domestic __ Public supply __ Industry
X Irrigation __ Air conditioning __ Stock
__ Lawn __ Oil field water __ Other

9. Casing: Material Steel Height: (Above) or below
Threaded ___ Welded X Surface 10 in.
RMP ___ PVC ___ Weight 31.67 lbs./ft.
Dia. 16 in. to 200 ft. depth Wall Thickness: inches or
Dia. ___ in. to ___ ft. depth gage No. .188

5. Type and color of material	From	To
Clay	0	38
Gyp	38	51
Clay	51	77
Fine sd clay	77	128
Sd coarse	128	138
Fine sd clay	138	171
Fine sd	171	177
Fine sd clay	177	179
Sd coarse	179	192
Yellow	192	195
Shale	195	
(Use a second sheet if needed)		

10. Screen: Manufacturer's name Johnson & Free Flow
Type Galv. & Prime Steel Dia. 16 in.
(Slot) gauze .100 & .125 Length 28 ft.
Set between 172 ft. and 200 ft.
___ ft. and ___ ft.
Gravel pack yes Size range of material 3/4-¼

11. Static water level: mo./day/yr.
162 ft. below land surface Date 11-25-75

12. Pumping level below land surfaces:
181 ft. after 8 hrs. pumping 300 g.p.m.
___ ft. after ___ hrs. pumping ___ g.p.m.
Estimated maximum yield 300 g.p.m.

13. Water sample submitted: mo./day/yr.
___ Yes X No Date ___

14. Well head completion:
___ Pitless adapter ___ Inches above grade

15. Well grouted? ___
With: ✓ Neat cement ___ Bentonite ___ Concrete
Depth: From 0 ft. to 10 ft.

16. Nearest source of possible contamination:
ft. 2640 Direction W Type Septic
Well disinfected upon completion? X Yes ___ No

17. Pump: ___ Not installed
Manufacturer's name Layne & Bowler
Model number ___ HP ___ Volts ___
Length of drop pipe 185 ft. capacity 300 g.p.m.
Type:
___ Submersible X Turbine
___ Jet ___ Reciprocating
___ Centrifugal ___ Other

18. Elevation:

Topography:
___ Hill
___ Slope
X Upland
___ Valley

19. Remarks:

20. Water well contractor's certification:
This well was drilled under my jurisdiction and this report is true to the best of my knowledge and belief.
Weishaar Drilling 232
Business name License No.
Address Scott City, KS 67871
Signed [signature] Date
Authorized representative 7-20-76

T 16 R 33 E (W) Sec 19 1/4 1/4 1/4

Forward the white, blue and pink copies to the Department of Health and Environment

Form WWC-5

MI-1023