


1 LOCATION OF WATER WELL: Fraction NW 1/4 NW 1/4 NW 1/4 Section Number 25 Township Number T 16 S Range Number R 33 EW

Distance and direction from nearest town or city street address of well if located within city?
 10 1/2 miles north & 1 mile west of Scott City, Ks.

2 WATER WELL OWNER: Duane Stoppel
 RR#, St. Address, Box #: Scott City, Ks. 67871
 Board of Agriculture, Division of Water Resources
 City, State, ZIP Code: Scott City, Ks. 67871
 Application Number:

3 LOCATE WELL'S LOCATION WITH AN "X" IN SECTION BOX:

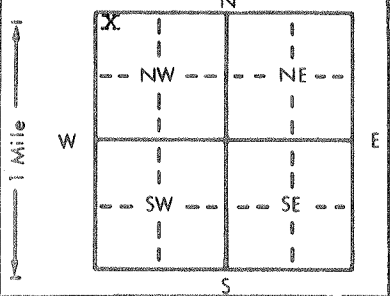

4 DEPTH OF COMPLETED WELL: 90 ft. ELEVATION:

Depth(s) Groundwater Encountered 1. ft. 2. ft. 3. ft.
 WELL'S STATIC WATER LEVEL . . . 30 . . . ft. below land surface measured on mo/day/yr . . . 5-7-90
 Pump test data: Well water was ft. after hours pumping gpm
 Est. Yield . . . 30 . . . gpm: Well water was . . . 56 . . . ft. after hours pumping gpm
 Bore Hole Diameter . . . 10 . . . in. to . . . 90 . . . ft., and in. to ft.
 WELL WATER TO BE USED AS: 5 Public water supply 8 Air conditioning 11 Injection well
 ① Domestic 3 Feedlot 6 Oil field water supply 9 Dewatering X2 Other (Specify below)
 2 Irrigation 4 Industrial 7 Lawn and garden only 10 Monitoring well stock
 Was a chemical/bacteriological sample submitted to Department? Yes No X; If yes, mo/day/yr sample was submitted
 Water Well Disinfected? Yes X No

5 TYPE OF BLANK CASING USED: 5 Wrought iron 8 Concrete tile CASING JOINTS: Glued X Clamped
 1 Steel 3 RMP (SR) 6 Asbestos-Cement 9 Other (specify below) Welded
 X PVC 4 ABS 7 Fiberglass Threaded

Blank casing diameter . . . 5 . . . in. to . . . 90 . . . ft., Dia in. to ft., Dia in. to ft.
 Casing height above land surface . . . 12 . . . in., weight lbs./ft. Wall thickness or gauge No. . . 200 psi

TYPE OF SCREEN OR PERFORATION MATERIAL: X PVC 10 Asbestos-cement
 1 Steel 3 Stainless steel 5 Fiberglass 8 RMP (SR) 11 Other (specify)
 2 Brass 4 Galvanized steel 6 Concrete tile 9 ABS 12 None used (open hole)

SCREEN OR PERFORATION OPENINGS ARE: 5 Gauzed wrapped X Saw cut 11 None (open hole)
 1 Continuous slot 3 Mill slot 6 Wire wrapped 9 Drilled holes
 2 Louvered shutter 4 Key punched 7 Torch cut 10 Other (specify)

SCREEN-PERFORATED INTERVALS: From . . . 75 . . . ft. to . . . 90 . . . ft., From ft. to ft.
 From ft. to ft., From ft. to ft.
 GRAVEL PACK INTERVALS: From . . . 25 . . . ft. to . . . 65 . . . ft., From ft. to ft.
 From . . . 75 . . . ft. to . . . 90 . . . ft., From ft. to ft.

6 GROUT MATERIAL: 1 Neat cement X Cement grout X Bentonite 4 Other
 Grout Intervals: From . . . 5 . . . ft. to . . . 25 . . . ft., From ft. to ft., From ft. to ft.

What is the nearest source of possible contamination: X Livestock pens 14 Abandoned water well
 1 Septic tank 4 Lateral lines 7 Pit privy 11 Fuel storage 15 Oil well/Gas well
 2 Sewer lines 5 Cess pool 8 Sewage lagoon 12 Fertilizer storage 16 Other (specify below)
 3 Watertight sewer lines 6 Seepage pit 9 Feedyard 13 Insecticide storage
 Direction from well? South East How many feet? 1000

FROM	TO	LITHOLOGIC LOG	FROM	TO	PLUGGING INTERVALS
0	21	gypsum & brown clay			
21	61	fine sand, brown sand streaks			
61	81	fine sand			
81	87	coarse sand			
87	90	yellow clay			

7 CONTRACTOR'S OR LANDOWNER'S CERTIFICATION: This water well was (X) constructed, (2) reconstructed, or (3) plugged under my jurisdiction and was completed on (mo/day/year) . . . 5-7-90 and this record is true to the best of my knowledge and belief. Kansas Water Well Contractor's License No. . . . 449 This Water Well Record was completed on (mo/day/yr) . . . 5-7-90 under the business name of Midwest Well & Pump by (signature) Arthur Kuhlman

INSTRUCTIONS: Use typewriter or ball point pen. PLEASE PRESS FIRMLY and PRINT clearly. Please fill in blanks, underline or circle the correct answers. Send top three copies to Kansas Department of Health and Environment, Bureau of Water Protection, Topeka, Kansas 66620-7320. Telephone: 913-296-5514. Send one to WATER WELL OWNER and retain one for your records.