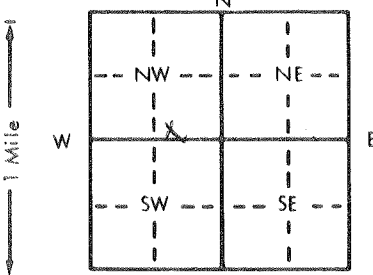


1 LOCATION OF WATER WELL: Fraction SW 1/4 SE 1/4 NW 1/4 Section Number 25 Township Number T 16 S Range Number R 33 EW  
 County: Scott

Distance and direction from nearest town or city street address of well if located within city?  
10 1/2 miles North 3/4 mile West of Scott City, Kansas

2 WATER WELL OWNER: Dale Dickhut  
 RR#, St. Address, Box #: Box 37 Board of Agriculture, Division of Water Resources  
 City, State, ZIP Code: Scott City, Kansas 67871 Application Number:

3 LOCATE WELL'S LOCATION WITH AN "X" IN SECTION BOX:  


4 DEPTH OF COMPLETED WELL: 155 ft. ELEVATION:  
 Depth(s) Groundwater Encountered 1. 87 ft. 2. ft. 3. ft.  
 WELL'S STATIC WATER LEVEL: 87 ft. below land surface measured on mo/day/yr 1/25/85  
 Pump test data: Well water was ft. after hours pumping gpm  
 Est. Yield gpm: Well water was ft. after hours pumping gpm  
 Bore Hole Diameter: 9 in. to 155 ft., and in. to ft.  
 WELL WATER TO BE USED AS:  
 1 Domestic  3 Feedlot  6 Oil field water supply  9 Dewatering  12 Other (Specify below) Stockwell  
 2 Irrigation  4 Industrial  7 Lawn and garden only  10 Observation well  
 Was a chemical/bacteriological sample submitted to Department? Yes No  X; If yes, mo/day/yr sample was submitted  
 Water Well Disinfected? Yes  X No

5 TYPE OF BLANK CASING USED:  
 1 Steel  3 RMP (SR)  6 Asbestos-Cement  9 Other (specify below)  CASING JOINTS: Glued Clamped  
 2 PVC  4 ABS  7 Fiberglass Threaded  
 Blank casing diameter: 5 in. to 135 ft., Dia. in. to ft., Dia. in. to ft.  
 Casing height above land surface: 12 in., weight 2.9 lbs./ft. Wall thickness or gauge No. 265

TYPE OF SCREEN OR PERFORATION MATERIAL:  
 1 Steel  3 Stainless steel  5 Fiberglass  7 PVC  10 Asbestos-cement  
 2 Brass  4 Galvanized steel  6 Concrete tile  9 ABS  11 Other (specify)  
 12 None used (open hole)

SCREEN OR PERFORATION OPENINGS ARE:  
 1 Continuous slot  3 Mill slot  4 Gauzed wrapped  8 Saw cut  11 None (open hole)  
 2 Louvered shutter  4 Key punched  6 Wire wrapped  9 Drilled holes  
 7 Torch cut  10 Other (specify)

SCREEN-PERFORATED INTERVALS: From 135 ft. to 155 ft., From ft. to ft.  
 GRAVEL PACK INTERVALS: From 90 ft. to 155 ft., From ft. to ft.

6 GROUT MATERIAL:  1 Neat cement  2 Cement grout  3 Bentonite  4 Other Drill cuttings  
 Grout Intervals: From 15 ft. to 90 ft., From 4 ft. to 15 ft., From ft. to ft.  
 What is the nearest source of possible contamination:  
 1 Septic tank  4 Lateral lines  7 Pit privy  10 Livestock pens  14 Abandoned water well  
 2 Sewer lines  5 Cess pool  8 Sewage lagoon  11 Fuel storage  15 Oil well/Gas well  
 3 Watertight sewer lines  6 Seepage pit  9 Feedyard  12 Fertilizer storage  16 Other (specify below)  
 13 Insecticide storage  
 Direction from well? East How many feet? 100

FROM	TO	LITHOLOGIC LOG	FROM	TO	LITHOLOGIC LOG
0	8	Top soil	8	12	Caliche
12	24	Fine sand	24	31	Sand
31	49	Caliche	49	61	Sand cemented
61	65	Sand	65	68	Sand cemented
68	85	Fine sand	85	93	Sand
93	98	Clay	98	105	Fine sand clay streaks
105	132	Fine sand	132	134	Clay
134	149	Fine to medium sand	149	152	Sand
152	155	Clay			

7 CONTRACTOR'S OR LANDOWNER'S CERTIFICATION: This water well was  (1) constructed,  (2) reconstructed, or  (3) plugged under my jurisdiction and was completed on (mo/day/year) 1/25/85 and this record is true to the best of my knowledge and belief. Kansas Water Well Contractor's License No. 232 This Water Well Record was completed on (mo/day/yr) 1/29/85 under the business name of Weishaar Drilling & Supply Inc. by (signature) [Signature]

INSTRUCTIONS: Use typewriter or ball point pen, PLEASE PRESS FIRMLY and PRINT clearly. Please fill in blanks, underline or circle the correct answers. Send top three copies to Kansas Department of Health and Environment, Division of Environment, Environmental Geology Section, Topeka, KS 66620. Send one to WATER WELL OWNER and retain one for your records.