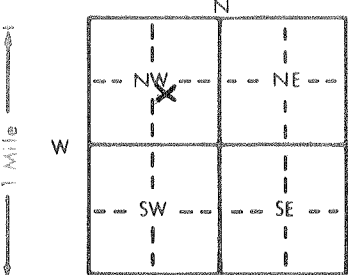


1] LOCATION OF WATER WELL: Fraction NW 1/4 SE 1/4 NW 1/4 Section Number 30 Township Number T 16 S Range Number R 33 EW  
 County: Scott

Distance and direction from nearest town or city street address of well if located within city?  
10 miles north + 5 1/2 miles west of Scott City, Ks.

2] WATER WELL OWNER: Royal Beef Inc.  
 RR#, St. Address, Box #: RR #3  
 City, State, ZIP Code: Scott City, KS 67871  
 Board of Agriculture, Division of Water Resources  
 Application Number:

3] LOCATE WELL'S LOCATION WITH AN "X" IN SECTION BOX:  
  
 4] DEPTH OF COMPLETED WELL: 184 ft. ELEVATION: ..... ft.  
 Depth(s) Groundwater Encountered 1. .... ft. 2. .... ft. 3. .... ft.  
 WELL'S STATIC WATER LEVEL: 155 ft. below land surface measured on mo/day/yr 10-8-90  
 Pump test data: Well water was ..... ft. after ..... hours pumping ..... gpm  
 Est. Yield 30 gpm: Well water was 22 ft. after ..... hours pumping ..... gpm  
 Bore Hole Diameter: 10 in. to 184 ft., and ..... in. to ..... ft.  
 WELL WATER TO BE USED AS:  
 5 Public water supply 8 Air conditioning 11 Injection well  
 1 Domestic  Feedlot 6 Oil field water supply 9 Dewatering 12 Other (Specify below)  
 2 Irrigation 4 Industrial 7 Lawn and garden only 10 Monitoring well  
 Was a chemical/bacteriological sample submitted to Department? Yes.....No .....; If yes, mo/day/yr sample was submitted  
 Water Well Disinfected? Yes  No

5] TYPE OF BLANK CASING USED:  
 1 Steel  PVC 3 RMP (SR) 4 ABS 5 Wrought iron 6 Asbestos-Cement 7 Fiberglass 8 Concrete tile 9 Other (specify below) CASING JOINTS: Glued  Clamped .....  
 Blank casing diameter: 5 in. to 184 ft., Dia ..... in. to ..... ft., Dia ..... in. to ..... ft.  
 Casing height above land surface: 12 in., weight ..... lbs./ft. Wall thickness or gauge No. 200 psi

TYPE OF SCREEN OR PERFORATION MATERIAL:  
 1 Steel 3 Stainless steel 5 Fiberglass 8 RMP (SR) 10 Asbestos-cement  
 2 Brass 4 Galvanized steel 6 Concrete tile 9 ABS 11 Other (specify) .....  
 12 None used (open hole)

SCREEN OR PERFORATION OPENINGS ARE:  
 1 Continuous slot 3 Mill slot 5 Gauzed wrapped 8 Saw cut 11 None (open hole)  
 2 Louvered shutter 4 Key punched 6 Wire wrapped 9 Drilled holes  
 7 Torch cut 10 Other (specify) .....

SCREEN-PERFORATED INTERVALS: From 154 ft. to 184 ft., From ..... ft. to ..... ft.  
 GRAVEL PACK INTERVALS: From 25 ft. to 154 ft., From ..... ft. to ..... ft.  
 From 164 ft. to 184 ft., From ..... ft. to ..... ft.

6] GROUT MATERIAL: 1 Neat cement  Cement grout  Bentonite chips 4 Other .....  
 Grout Intervals: From 5 ft. to 25 ft., From ..... ft. to ..... ft., From ..... ft. to ..... ft.

What is the nearest source of possible contamination:  
 1 Septic tank 4 Lateral lines 7 Pit privy 10 Livestock pens 14 Abandoned water well  
 2 Sewer lines 5 Cess pool 8 Sewage lagoon 11 Fuel storage 15 Oil well/Gas well  
 3 Watertight sewer lines 6 Seepage pit  Feedyard 12 Fertilizer storage 16 Other (specify below)  
 13 Insecticide storage

Direction from well? How many feet? 1000

| FROM | TO  | LITHOLOGIC LOG              | FROM | TO | PLUGGING INTERVALS |
|------|-----|-----------------------------|------|----|--------------------|
| 0    | 1   | top soil                    |      |    |                    |
| 1    | 47  | brown clay + gypsum         |      |    |                    |
| 47   | 55  | Fine + coarse sand          |      |    |                    |
| 55   | 64  | brown clay + gypsum         |      |    |                    |
| 64   | 74  | Fine + coarse sand          |      |    |                    |
| 74   | 82  | brown clay + gypsum         |      |    |                    |
| 82   | 92  | Fine sand with clay streaks |      |    |                    |
| 92   | 100 | brown clay                  |      |    |                    |
| 100  | 105 | Fine sand + coarse sand     |      |    |                    |
| 105  | 152 | Fine sand                   |      |    |                    |
| 152  | 170 | Fine sand with clay streaks |      |    |                    |
| 170  | 174 | brown clay                  |      |    |                    |
| 174  | 182 | Coarse sand + small gravel  |      |    |                    |
| 182  | 184 | black shale                 |      |    |                    |

7] CONTRACTOR'S OR LANDOWNER'S CERTIFICATION: This water well was  constructed, (2) reconstructed, or (3) plugged under my jurisdiction and was completed on (mo/day/year) 10-8-90 and this record is true to the best of my knowledge and belief. Kansas Water Well Contractor's License No. 532 This Water Well Record was completed on (mo/day/yr) 10-15-90 under the business name of Midwest Well + Pump by (signature) Victor Jankup

INSTRUCTIONS: Use typewriter or ball point pen. PLEASE PRESS FIRMLY and PRINT clearly. Please fill in blanks, underline or circle the correct answers. Send top three copies to Kansas Department of Health and Environment, Bureau of Water, Topeka, Kansas 66620-7320. Telephone: 913-296-5545. Send one to WATER WELL OWNER and retain one for your records.