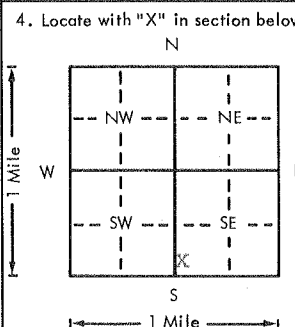
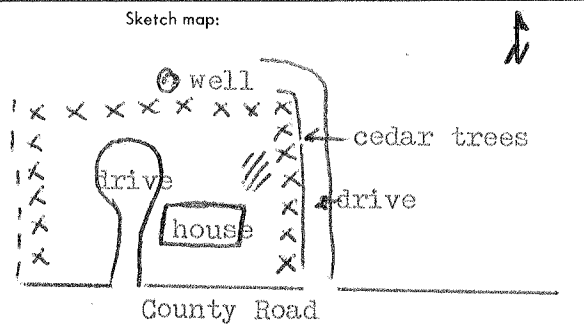



USE TYPEWRITER OR BALL POINT PEN-PRESS FIRMLY, PRINT CLEARLY.

WATER WELL RECORD
KSA 82a-1201-1215

Kansas Department of Health and Environment-Division of Environment (Water well Contractors) Topeka, Kansas 66620

1. Location of well:		County <u>Scott</u>	Fraction <u>SW 1/4 SW 1/4 SE 1/4</u>	Section number <u>33</u>	Township number <u>T 16 S R 33</u>	Range number <u>33</u>
2. Distance and direction from nearest town or city: <u>8 miles N, 3 mi W, 1 mi N, & 1/2 mi West from</u> Street address of well location if in city: <u>Scott City</u>			3. Owner of well: <u>Gary Koehn</u> R.R. or street: <u>RFD 3</u> City, state, zip code: <u>Scott City, KS 67871</u>			
4. Locate with "X" in section below: 		Sketch map: 		6. Bore hole dia. <u>9</u> in. Completion date _____ Well depth <u>163</u> ft. <u>1-5-78</u>		
5. Type and color of material						
		From	To	7. <input type="checkbox"/> Cable tool <input checked="" type="checkbox"/> Rotary <input type="checkbox"/> Driven <input type="checkbox"/> Dug <input type="checkbox"/> Hollow rod <input type="checkbox"/> Jetted <input type="checkbox"/> Bored <input type="checkbox"/> Reverse rotary		
Dirt & clay		0	28	8. Use: <input checked="" type="checkbox"/> Domestic <input type="checkbox"/> Public supply <input type="checkbox"/> Industry <input type="checkbox"/> Irrigation <input type="checkbox"/> Air conditioning <input type="checkbox"/> Stock <input type="checkbox"/> Lawn <input type="checkbox"/> Oil field water <input type="checkbox"/> Other		
Gyp		28	43	9. Casing: Material _____ Height: Above or below Threaded _____ Welded _____ Surface <u>12</u> in. RMP _____ PVC <input checked="" type="checkbox"/> Weight _____ lbs./ft. Dia. <u>5</u> in. to <u>123</u> ft. depth Wall Thickness: _____ inches or Dia. _____ in. to _____ ft. depth gage No. <u>0.265</u>		
Gyp and sand rock		43	84	10. Screen: Manufacturer's name <u>Peerless Plastic, Inc.</u> Type <u>PVC 200</u> Dia. <u>5"</u> Slot/gauze <u>0.040</u> Length <u>39</u> ft. Set between <u>124</u> ft. and <u>163</u> ft. ft. and _____ ft. Gravel pack? <input checked="" type="checkbox"/> yes Size range of material <u>1/8" down</u>		
Sandrock		84	123	11. Static water level: _____ mo./day/yr. <u>127</u> ft. below land surface Date <u>1-5-78</u>		
medium to coarse sand, clean		123	139	12. Pumping level below land surfaces: <u>162</u> ft. after <u>10</u> hrs. pumping <u>8+</u> g.p.m. _____ ft. after _____ hrs. pumping _____ g.p.m. Estimated maximum yield <u>8+</u> g.p.m.		
clay and fine sand		139	143	13. Water sample submitted: _____ mo./day/yr. Yes <input type="checkbox"/> No <input checked="" type="checkbox"/> Date _____		
fine sand		143	148	14. Well head completion: <input checked="" type="checkbox"/> Pitless adapter <u>12</u> inches above grade		
Sandy clay		148	158	15. Well grouted? <input checked="" type="checkbox"/> yes With: <input checked="" type="checkbox"/> Neat cement <input checked="" type="checkbox"/> Bentonite _____ Concrete Depth: From <u>17</u> ft. to <u>5</u> ft.		
* sandy clay		163	191	16. Nearest source of possible contamination: <u>drain</u> ft. <u>100+</u> Direction <u>SE</u> Type <u>field</u> Well disinfected upon completion? <input checked="" type="checkbox"/> Yes <input type="checkbox"/> No		
*Blue shale		191		17. Pump: _____ Not installed Manufacturer's name <u>Aermotor</u> Model number <u>SD8-75</u> HP <u>3/4</u> Volts <u>230</u> Length of drop pipe <u>160</u> ft. capacity <u>8</u> g.p.m. Type: <input checked="" type="checkbox"/> Submersible _____ Turbine <input type="checkbox"/> Jet _____ Reciprocating <input type="checkbox"/> Centrifugal _____ Other		
(Use a second sheet if needed)						
18. Elevation: Topography: <input type="checkbox"/> Hill <input type="checkbox"/> Slope <input type="checkbox"/> Upland <input type="checkbox"/> Valley		19. Remarks: 		20. Water well contractor's certification: This well was drilled under my jurisdiction and this report is true to the best of my knowledge and belief. <u>ABC Drilling, Inc</u> <u>246</u> Business name License No. Address <u>Scott City, KS 67871</u> Signed <u>Sy Ross</u> Date <u>2-1-78</u> Authorized representative		

T
R
W
Sec
1/4
1/4
1/4