WATER WELL PLUGGING RECORD FORM WWC-5P KSA 82a-1212

1 LOCATION OF WATER WELL:	Fraction	Section Number	Township Number	Range Number
County: **Scott**	**NE** ¼ **NW** ¼ **NW** ¼	**26**	**16**	**34W**

Distance and direction from nearest town or city street address of well if located within city?
North of Scott City 9 miles on Hwy 83—2.2 miles NW on Hwt 95—7.7 miles west on Rd 270—1 mile south on trail

2 WATER WELL OWNER: **Delbert Becker**
RR#, St. Address, Box # **14914 FM 296**
City, State, ZIP Code : **Salem, IL 62881**

Board of Agriculture, Division of Water Resources
Application Number: 2011 0263

3 MARK WELL'S LOCATON WITH AN "X" IN SECTION BOX:

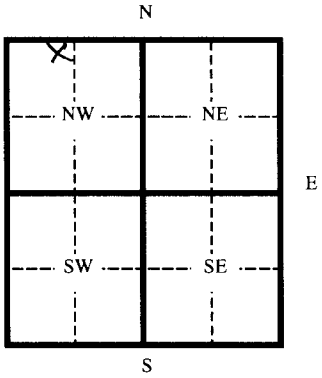

4 DEPTH OF WELL **200** ft.

WELL'S STATIC WATER LEVEL **165** ft.

WELL WAS USED AS:

1 Domestic 5 Public Water Supply 9 Dewatering
2 Irrigation [6] Oil Field Water Supply 10 Monitoring Well
3 Feedlot 7 Lawn and Garden (domestic) 11 Injection Well
4 Industrial 8 12 Other

Was a chemical/bacteriological sample submitted to Department? Yes ___ No **X**
If yes, mo/day/yr sample was submitted
Water Well Disinfected: Yes **X** No

5 TYPE OF BLANK CASING USED:
1 Steel 3 RMP (SR) 5 Wrought 7 Fiberglass 9 Other (specify below)
[2] PVC 4 ABC 6 Asbestos-Cement 8 Concrete Tile

Blank casing diameter **4.5** in. Was casing pulled? Yes ___ No **X** If yes, how much

Casing height above or below land surface **-36** in.

6 GROUT PLUG MATERIAL: 1 Neat cement 2 Cement grout 3 Bentonite 4 Other

Grout Plug Intervals From **3** ft. to **6** ft. From **162** ft. to **165** ft. From ___ ft. to ___ ft.

What is the nearest source of possible contamination:

1 Septic tank 6 Seepage pit 11 Fuel storage 16 Other (specify below)
2 Sewer lines 7 Pit privy 12 Fertilizer storage
3 Watertight sewer lines 8 Sewage lagoon 13 Insecticide storage
4 Lateral lines 9 Feedyard 14 Abandoned water well
5 Cess Pool 10 Livestock pens 15 Oil well/ Gas well

Direction from well? How many feet?

FROM	TO	CODE	PLUGGING MATERIALS
0	3		Native soil
3	6		Bentonite
6	162		Clay
162	165		Bentonite
165	200		Chlorinated Sand

7 CONTRACTOR'S OR LANDOWNER'S CERTIFICATION: This water well was plugged under my jurisdiction and was completed on (mo/day/yr) **2/28/12** and this record is true to the best of my knowledge and belief. Kansas Water Well Contractor's License No. **554** This Water Well Record was completed on (mo/day/yr) **3/5/12** under the business name of **Woofter Pump & Well Inc.**
by (signature) Jay C. Woofter

INSTRUCTIONS: Please fill in blanks and circle the correct answers. Send three copies to Kansas Department of Health and Environment, Bureau of Water, Topeka, Kansas 66620-0001. Telephone: 785-296-3565. Send one to Water Well Owner and retain one for your records.

Form provided by Forms On-A-Disk, Inc. · Dallas, Texas · (214) 340-9429