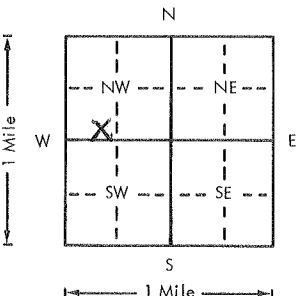


USE TYPEWRITER OR BALL POINT PEN-PRESS FIRMLY, PRINT CLEARLY.

WATER WELL RECORD
KSA 82a-1201-1215

Kansas Department of Health and Environment-Division of Environment (Water well Contractors) Topeka, Kansas 66620

1. Location of well:		County Scott	Fraction SE 1/4 SW 1/4 NW 1/4	Section number 2	Township number T 16 S R 34 E	Range number 34 E
2. Distance and direction from nearest town or city: 12N, 7W, 2N, 1W, Street address of well location if in city: 1/2 N, 1/4 E of Scott City, KS			3. Owner of well: Marvin Eitel R.R. or street: RFD #1 City, state, zip code: Scott City, KS 67871			
4. Locate with "X" in section below: 			Sketch map: X well 3/4 mi. [Septic]			6. Bore hole dia. 9 in. Completion date _____ Well depth 150 ft. 4-28-77
5. Type and color of material			From	To	7. <input type="checkbox"/> Cable tool <input checked="" type="checkbox"/> Rotary <input type="checkbox"/> Driven <input type="checkbox"/> Dug <input type="checkbox"/> Hollow rod <input type="checkbox"/> Jetted <input type="checkbox"/> Bored <input type="checkbox"/> Reverse rotary	
Clay			0	30	8. Use: <input type="checkbox"/> Domestic <input type="checkbox"/> Public supply <input type="checkbox"/> Industry <input type="checkbox"/> Irrigation <input type="checkbox"/> Air conditioning <input checked="" type="checkbox"/> Stock <input type="checkbox"/> Lawn <input type="checkbox"/> Oil field water <input type="checkbox"/> Other	
Gyp H			30	44	9. Casing: Material Plas. Height Above or below Threaded <input type="checkbox"/> Welded <input checked="" type="checkbox"/> Glue Surface 12 in. RMP <input checked="" type="checkbox"/> PVC _____ Weight 1.8 lbs./ft. Dia. 5 in. to 130 ft. depth Wall Thickness: inches or Dia. _____ in. to _____ ft. depth gage No. 250	
Gyp			44	68	10. Screen: Manufacturer's name _____ Jess & Lowell Type RMP Dia. 5 in. <input checked="" type="checkbox"/> gauze 1/16 Length 20 ft. Set between 130 ft. and 150 ft. _____ ft. and _____ ft. Gravel pack? Yes Size range of material 1/4-1/8	
Clay			68	100	11. Static water level: _____ mo./day/yr. 139 ft. below land surface Date 4-26-77	
Sdy clay T			100	117	12. Pumping level below land surfaces: 149 ft. after 1 hrs. pumping 4 g.p.m. _____ ft. after _____ hrs. pumping _____ g.p.m. Estimated maximum yield 4 g.p.m.	
Sd coarse			117	142	13. Water sample submitted: _____ mo./day/yr. Yes <input checked="" type="checkbox"/> No <input type="checkbox"/> Date _____	
Sd rock			142	143	14. Well head completion: _____ <input type="checkbox"/> Pitless adapter 12 inches above grade	
Yellow			143	150	15. Well grouted? yes With: <input checked="" type="checkbox"/> Neat cement <input type="checkbox"/> Bentonite <input type="checkbox"/> Concrete Depth: From 0 ft. to 15 ft.	
Shale			150		16. Nearest source of possible contamination: ft. 3960 Direction SE Type Septic Well disinfected upon completion? <input checked="" type="checkbox"/> Yes <input type="checkbox"/> No	
					17. Pump: _____ Not installed Manufacturer's name Aermotor Model number _____ HP _____ Volts _____ Length of drop pipe 149 ft. capacity 4 g.p.m. Type: <input type="checkbox"/> Submersible <input type="checkbox"/> Turbine <input type="checkbox"/> Jet <input type="checkbox"/> Reciprocating <input type="checkbox"/> Centrifugal <input checked="" type="checkbox"/> Windmill <input checked="" type="checkbox"/> Other	
					20. Water well contractor's certification: This well was drilled under my jurisdiction and this report is true to the best of my knowledge and belief. Weishaar Drillers 232 Business name _____ License No. _____ Address Scott City, KS 67871 Signature _____ Date 4-29-77 Authorized representative	
18. Elevation:		19. Remarks:				
Topography: <input type="checkbox"/> Hill <input checked="" type="checkbox"/> Slope <input type="checkbox"/> Upland <input type="checkbox"/> Valley						

Forward the white, blue and pink copies to the Department of Health and Environment

Form WWC-5