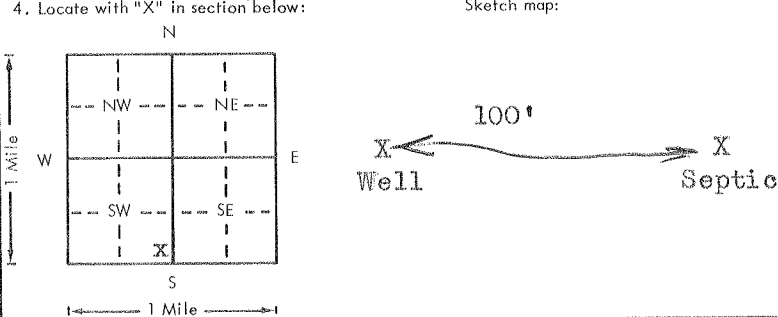


USE TYPEWRITER OR BALL POINT PEN-PRESS FIRMLY, PRINT CLEARLY.

WATER WELL RECORD
KSA 82a-1201-1215

Kansas Department of Health and Environment-Division of Environment (Water well Contractors) Topeka, Kansas 66620

1. Location of well:	County Scott	Fraction SE 1/4 SE 1/4 SW 1/4	Section number 17	Township number T 16 S R 34	Range number W
2. Distance and direction from nearest town or city: 1 1/2 Miles West of Pence, Kansas Street address of well location if in city:			3. Owner of well: Paul Unruh R.R. or street: Scott City, Kansas 67871 City, state, zip code:		
4. Locate with "X" in section below: Sketch map: 			6. Bore hole dia. <u>9</u> in. Completion date _____ Well depth <u>185</u> ft. <u>6/27/79</u>		
5. Type and color of material			7. <input checked="" type="checkbox"/> Cable tool <input checked="" type="checkbox"/> Rotary <input type="checkbox"/> Driven <input type="checkbox"/> Dug <input type="checkbox"/> Hollow rod <input type="checkbox"/> Jetted <input type="checkbox"/> Bored <input type="checkbox"/> Reverse rotary		
			8. Use: <input checked="" type="checkbox"/> Domestic <input type="checkbox"/> Public supply <input type="checkbox"/> Industry <input type="checkbox"/> Irrigation <input type="checkbox"/> Air conditioning <input type="checkbox"/> Stock <input type="checkbox"/> Lawn <input type="checkbox"/> Oil field water <input type="checkbox"/> Other		
			9. Casing: Material <u>Plastic</u> Height: Above or below Threaded _____ Welded <u>Glue</u> Surface <u>12</u> in. RMP <input checked="" type="checkbox"/> PVC _____ Weight <u>1.8</u> lbs./ft. Dia. <u>5</u> in. to <u>165</u> ft. depth Wall Thickness: inches or Dia. _____ in. to _____ ft. depth gage No. <u>250</u>		
			10. Screen: Manufacturer's name <u>Jess & Lowell</u> Type <u>RMP</u> Dia. <u>5th</u> Slot/gauze <u>1/16th</u> Length <u>20'</u> Set between <u>165</u> ft. and <u>185</u> ft. _____ ft. and _____ ft. Gravel pack? <u>yes</u> Size range of material <u>2x1/8th</u>		
			11. Static water level: _____ mo./day/yr. <u>156</u> ft. below land surface Date <u>6/19/79</u>		
			12. Pumping level below land surfaces: <u>167</u> ft. after <u>4</u> hrs. pumping <u>30</u> g.p.m. _____ ft. after _____ hrs. pumping _____ g.p.m. Estimated maximum yield <u>30</u> g.p.m.		
			13. Water sample submitted: _____ mo./day/yr. <input type="checkbox"/> Yes <input checked="" type="checkbox"/> No Date _____		
			14. Well head completion: <input checked="" type="checkbox"/> Pitless adapter _____ Inches above grade		
			15. Well grouted? <u>yes</u> With: <input checked="" type="checkbox"/> Neat cement _____ Bentonite _____ Concrete _____ Depth: From <u>0</u> ft. to <u>15</u> ft.		
			16. Nearest source of possible contamination: ft. <u>100</u> Direction <u>East</u> Type <u>Septic</u> Well disinfected upon completion? <input checked="" type="checkbox"/> Yes _____ No		
			17. Pump: _____ Not installed Manufacturer's name <u>Red Jacket</u> Model number <u>11DC</u> HP <u>3</u> Volts <u>230</u> Length of drop pipe <u>176</u> ft. capacity <u>30</u> g.p.m. Type: <input checked="" type="checkbox"/> Submersible _____ Turbine <input type="checkbox"/> Jet _____ Reciprocating <input type="checkbox"/> Centrifugal _____ Other		
			20. Water well contractor's certification: This well was drilled under my jurisdiction and this report is true to the best of my knowledge and belief. Weishaar Drilling & Supply 232 Business name License No. _____ Address <u>Scott City, Kansas 67871</u> Signed <u>[Signature]</u> Date <u>6/27/79</u> Authorized representative		
18. Elevation:		19. Remarks:			
Topography: <input type="checkbox"/> Hill <input checked="" type="checkbox"/> Slope <input checked="" type="checkbox"/> Upland <input type="checkbox"/> Valley					

Forward the white, blue and pink copies to the Department of Health and Environment

Form WWC-5