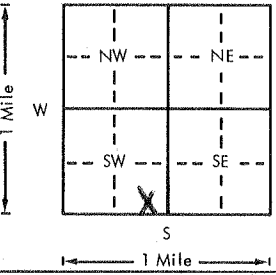
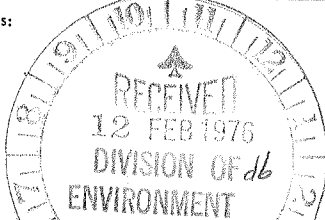


USE TYPEWRITER OR BALL POINT PEN-PRESS FIRMLY, PRINT CLEARLY.

WATER WELL RECORD
KSA 82a-1201-1215

Kansas Department of Health and Environment-Division of Environment
(Water well Contractors)
Topeka, Kansas 66620

1. Location of well:		County Scott	Fraction SE 1/4 SE 1/4 SW 1/4	Section number 23	Township number T 16 S	Range number R 34 E/W	
2. Distance and direction from nearest town or city: 1 1/2 mi East, 1 mi So. Pence Street address of well location if in city:				3. Owner of well: David J Koehn R.R. or street: Montezuma Ks. 67807 City, state, zip code:			
4. Locate with "X" in section below: N W E S 1 Mile 1 Mile				Sketch map: 		6. Bore hole dia. <u>2 1/4</u> in. Completion date <u>12-20-75</u> Well depth <u>207</u> ft.	
5. Type and color of material				From	To	7. <input type="checkbox"/> Cable tool <input checked="" type="checkbox"/> Rotary <input type="checkbox"/> Driven <input type="checkbox"/> Dug <input type="checkbox"/> Hollow rod <input type="checkbox"/> Jetted <input type="checkbox"/> Bored <input type="checkbox"/> Reverse rotary	
#3 Clay, gyp, sand				0	80	8. Use: <input type="checkbox"/> Domestic <input type="checkbox"/> Public supply <input type="checkbox"/> Industry <input checked="" type="checkbox"/> Irrigation <input type="checkbox"/> Air conditioning <input type="checkbox"/> Stock <input type="checkbox"/> Lawn <input type="checkbox"/> Oil field water <input type="checkbox"/> Other	
Clay, sand				80	160	9. Casing: Material <u>Steel</u> Height <u>Above</u> or below Threaded <input type="checkbox"/> Welded <input checked="" type="checkbox"/> Surface <u>12</u> in. RMP <input type="checkbox"/> PVC <input type="checkbox"/> Weight <u>3686</u> lbs./ft. Dia. <u>16</u> in. to <u>207</u> ft. depth; Wall thickness: inches or Dia. <u> </u> in. to <u> </u> ft. depth; gage No. <u>319</u>	
Sand fine to med. coarse, clay				20	160	180	10. Screen: Manufacturer's name <u>Lakewood</u> Type <u>Mill Slot</u> Dia. <u>16</u> Slot/gauze <u>1/8</u> Length <u>2"</u> Set between <u>15 1/4</u> ft. and <u>207</u> ft. ft. and <u> </u> ft. Gravel pack? <input checked="" type="checkbox"/> Yes Size range of material <u>1/2 x 5/8</u>
Gravel, clay balls, shale				18	180	200	11. Static water level: <u>160</u> ft. below land surface Date <u>12-20-75</u> mo./day/yr.
							12. Pumping level below land surfaces: <u>160</u> ft. after <u>5</u> hrs. pumping <u>500</u> g.p.m. <u> </u> ft. after <u> </u> hrs. pumping <u> </u> g.p.m. Estimated maximum yield <u>500</u> g.p.m.
							13. Water sample submitted: <u> </u> mo./day/yr. <input type="checkbox"/> Yes <input checked="" type="checkbox"/> No Date <u> </u>
							14. Well head completion: <input type="checkbox"/> Pitless adapter <input checked="" type="checkbox"/> <u> </u> Inches above grade
Installing used pumps later, don't know what it will be.							15. Well grouted? <input checked="" type="checkbox"/> Yes With: <input checked="" type="checkbox"/> Neat cement <input type="checkbox"/> Bentonite <input type="checkbox"/> Concrete Depth: From <u>0</u> ft. to <u>10</u> ft.
							16. Nearest source of possible contamination: <u>NA</u> ft. <u> </u> Direction <u> </u> Type <u> </u> Well disinfected upon completion? <input type="checkbox"/> Yes <input type="checkbox"/> No
							17. Pump: <input type="checkbox"/> Not installed Manufacturer's name <u> </u> Model number <u> </u> HP <u> </u> Volts <u> </u> Length of drop pipe <u> </u> ft. capacity <u> </u> g.p.m. Type: <input type="checkbox"/> Submersible <input type="checkbox"/> Turbine <input type="checkbox"/> Jet <input type="checkbox"/> Reciprocating <input type="checkbox"/> Centrifugal <input type="checkbox"/> Other
(Use a second sheet if needed)							20. Water well contractor's certification: This well was drilled under my jurisdiction and this report is true to the best of my knowledge and belief.
18. Elevation:	19. Remarks:		20. Water well contractor's certification: This well was drilled under my jurisdiction and this report is true to the best of my knowledge and belief.				
Topography: <input type="checkbox"/> Hill <input type="checkbox"/> Slope <input checked="" type="checkbox"/> Upland level <input type="checkbox"/> Valley			High Plains Drilling & supply Inc 136 Business name <u>High Plains Drilling & supply Inc</u> License No. <u> </u> Address <u>102 N 3rd Garden City Ks</u> Signed <u>Glenn E. Harbison</u> Date <u>2/10/76</u> Authorized representative				

T 16
 R 34
 E/W
 23
 Sec
 1/4
 1/4
 1/4

Forward the white, blue and pink copies to the Department of Health and Environment

Form WWC-5