


1 LOCATION OF WATER WELL: Fraction SW 1/4 SW 1/4 SW 1/4 Section Number 28 Township Number T 16 S Range Number R 34 E/W
 County: Scott

Distance and direction from nearest town or city street address of well if located within city?
Jct. 83 & 96 at Scott City, 8 miles North, 4 West, 1 North, 6 West, 1 North

2 WATER WELL OWNER: Janis Blakey
 RR#, St. Address, Box #: 196 Tudor Lane Board of Agriculture, Division of Water Resources
 City, State, ZIP Code: Edmonton Alberta, Canada T6J375 Application Number:

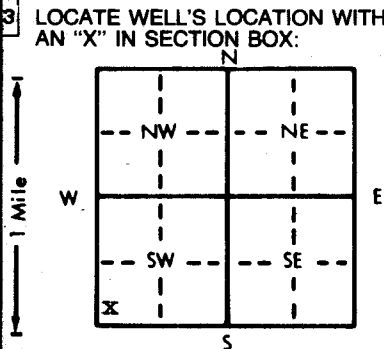

4 DEPTH OF COMPLETED WELL: 208 ft. ELEVATION:
 Depth(s) Groundwater Encountered 1. 170 ft. 2. ft. 3. ft.
 WELL'S STATIC WATER LEVEL 170 ft. below land surface measured on mo/day/yr 9/24/81
 Pump test data: Well water was 192 ft. after 1 hours pumping 191 gpm
 Est. Yield 190 gpm: Well water was ft. after hours pumping gpm
 Bore Hole Diameter: 28 in. to 208 ft., and in. to ft.
 WELL WATER TO BE USED AS:
 1 Domestic 3 Feedlot 6 Oil field water supply 9 Dewatering 12 Other (Specify below)
2 Irrigation 4 Industrial 7 Lawn and garden only 10 Observation well
 Was a chemical/bacteriological sample submitted to Department? Yes.....No : If yes, mo/day/yr sample was submitted
 Water Well Disinfected? Yes No

5 TYPE OF BLANK CASING USED:
 1 Steel 3 RMP (SR) 6 Asbestos-Cement 9 Other (specify below)
 2 PVC 4 ABS 7 Fiberglass
 Blank casing diameter 16 in. to 168 ft., Dia in. to ft., Dia in. to ft.
 Casing height above land surface 12 in., weight 37 lbs./ft. Wall thickness or gauge No. 219
 TYPE OF SCREEN OR PERFORATION MATERIAL:
 1 Steel 3 Stainless steel 5 Fiberglass 8 RMP (SR) 11 Other (specify)
 2 Brass 4 Galvanized steel 6 Concrete tile 9 ABS 12 None used (open hole)
 SCREEN OR PERFORATION OPENINGS ARE:
 1 Continuous slot 3 Mill slot 5 Gauzed wrapped 8 Saw cut 11 None (open hole)
 2 Louvered shutter 4 Key punched 6 Wire wrapped 9 Drilled holes
 7 Torch cut 10 Other (specify)
 SCREEN-PERFORATED INTERVALS: From 168 ft. to 208 ft., From ft. to ft.
 From ft. to ft., From ft. to ft.
 GRAVEL PACK INTERVALS: From 10 ft. to 208 ft., From ft. to ft.
 From ft. to ft., From ft. to ft.

6 GROUT MATERIAL: 1 Neat cement 2 Cement grout 3 Bentonite 4 Other
 Grout Intervals: From 0 ft. to 10 ft., From ft. to ft., From ft. to ft.
 What is the nearest source of possible contamination:
 1 Septic tank 4 Lateral lines 7 Pit privy 10 Livestock pens 14 Abandoned water well
 2 Sewer lines 5 Cess pool 8 Sewage lagoon 11 Fuel storage 15 Oil well/Gas well
 3 Watertight sewer lines 6 Seepage pit 9 Feedyard 12 Fertilizer storage 16 Other (specify below)

 Direction from well? How many feet?

FROM	TO	LITHOLOGIC LOG	FROM	TO	LITHOLOGIC LOG
0	4	Surface			
4	40	Clay			
40	78	Clay, sand, caliche, rock			
78	132	Loose sand & gravel			
132	146	Fine to medium loose sand			
146	188	Partly cemented fine sand			
188	198	Loose, fine to medium sand, gravel			
198	209	Yellow clay, rocks & gravel			
209	220	Shale			

7 CONTRACTOR'S OR LANDOWNER'S CERTIFICATION: This water well was constructed, reconstructed, or plugged under my jurisdiction and was completed on (mo/day/year) October 26, 1981 and this record is true to the best of my knowledge and belief. Kansas Water Well Contractor's License No. 102 This Water Well Record was completed on (mo/day/yr) November 18, 1981 under the business name of Layne-Western Company, Inc. by (signature) [Signature]

INSTRUCTIONS: Use typewriter or ball point pen, PLEASE PRESS FIRMLY and PRINT clearly. Please fill in blanks, underline or circle the correct answers. Send top three copies to Kansas Department of Health and Environment, Division of Environment, Environmental Geology Section, Topeka, KS 66620. Send one to WATER WELL OWNER and retain one for your records.

OFFICE USE ONLY

SEC. 28 SW 1/4 SW 1/4 SW 1/4