


1 LOCATION OF WATER WELL: County: SCOTT Fraction: SE 1/4 NE 1/4 SE 1/4 Section Number: 13 Township Number: T 16 S Range Number: R 34 E/W

Distance and direction from nearest town or city street address of well if located within city?
2 EAST PENC.

2 WATER WELL OWNER: DANNIE BAHM
RR#, St. Address, Box #: PT 3 BOX 123
City, State, ZIP Code: SCOTT CITY, KS.
Board of Agriculture, Division of Water Resources
Application Number:

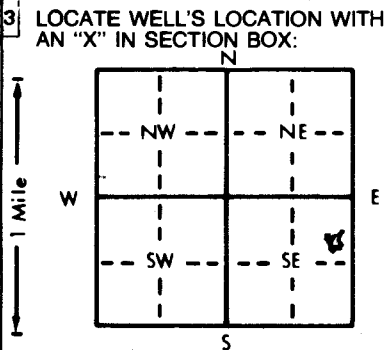

4 DEPTH OF COMPLETED WELL: 185 ft. ELEVATION: _____
Depth(s) Groundwater Encountered: 1 155 ft. 2 _____ ft. 3 _____ ft.
WELL'S STATIC WATER LEVEL: 155 ft. below land surface measured on mo/day/yr 9-24-94
Pump test data: Well water was _____ ft. after _____ hours pumping _____ gpm
Est. Yield: 20 gpm Well water was _____ ft. after _____ hours pumping _____ gpm
Bore Hole Diameter: 8 in. to _____ ft., and _____ in. to _____ ft.
WELL WATER TO BE USED AS:
 Domestic 3 Feedlot 6 Oil field water supply 9 Dewatering 12 Other (Specify below)
2 Irrigation 4 Industrial 7 Lawn and garden only 10 Monitoring well
Was a chemical/bacteriological sample submitted to Department? Yes _____ No _____; If yes, mo/day/yr sample was submitted _____
Water Well Disinfected? Yes No _____

5 TYPE OF CASING USED:
 Steel 20' 3 RMP (SR) 6 Asbestos-Cement 9 Other (specify below) Welded _____
 PVC 4 ABS 7 Fiberglass _____ Threaded _____
Casing diameter: 5 1/2 in. to 16 1/2 ft., Dia _____ in. to _____ ft., Dia _____ in. to _____ ft.
Casing height above land surface: 10 in., weight 190 lbs./ft. Wall thickness or gauge No. Sch. 40
TYPE OF SCREEN OR PERFORATION MATERIAL:
1 Steel 3 Stainless steel 5 Fiberglass 8 RMP (SR) 11 Other (specify) _____
2 Brass 4 Galvanized steel 6 Concrete tile 9 ABS 12 None used (open hole) _____
SCREEN OR PERFORATION OPENINGS ARE:
1 Continuous slot 3 Mill slot 5 Gauzed wrapped 8 Saw-cut 11 None (open hole)
2 Louvered shutter 4 Key punched 6 Wire wrapped 9 Drilled holes
7 Torch cut 10 Other (specify) _____
SCREEN-PERFORATED INTERVALS: From 165 ft. to 185 ft., From _____ ft. to _____ ft.
GRAVEL PACK INTERVALS: From 100 ft. to 105 ft., From _____ ft. to _____ ft.
8-12 Silica FILL SAND From 20 ft. to 100 ft., From _____ ft. to _____ ft.

6 GROUT MATERIAL: 1 Neat cement 2 Cement grout 3 Bentonite 4 Other _____
Grout Intervals: From 0 ft. to 20 ft., From _____ ft. to _____ ft., From _____ ft. to _____ ft.
What is the nearest source of possible contamination: NONE IN VIEW
1 Septic tank 4 Lateral lines 7 Pit privy 10 Livestock pens 14 Abandoned water well
2 Sewer lines 5 Cess pool 8 Sewage lagoon 11 Fuel storage 15 Oil well/Gas well
3 Watertight sewer lines 6 Seepage pit 9 Feedyard 12 Fertilizer storage 16 Other (specify below) _____
13 Insecticide storage _____
Direction from well? _____ How many feet? _____

FROM	TO	LITHOLOGIC LOG	FROM	TO	PLUGGING INTERVALS
0	20	Surface to Rock			
20	100	Rock 94'			
100	150	SANDY CLAY			
150	180	SAND TO 1/8" GRAVEL			
180	185	YELLOW SOAP STONE			

RECEIVED
SEP 29 1994
BUREAU OF WATER

7 CONTRACTOR'S OR LANDOWNER'S CERTIFICATION: This water well was (1) constructed, (2) reconstructed, or (3) plugged under my jurisdiction and was completed on (mo/day/year) 9-24-94 and this record is true to the best of my knowledge and belief. Kansas Water Well Contractor's License No. 484 This Water Well Record was completed on (mo/day/yr) 9-29-94 under the business name of School Drilling Co. by (signature) [Signature]

INSTRUCTIONS: Use typewriter or ball point pen. PLEASE PRESS FIRMLY and PRINT clearly. Please fill in blanks, underline or circle the correct answers. Send top three copies to Kansas Department of Health and Environment, Bureau of Water, Topeka, Kansas 66620-0001. Telephone: 913-296-5545. Send one to WATER WELL OWNER and retain one for your records.