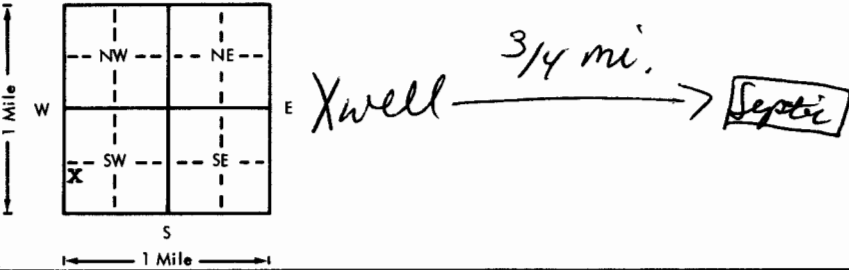


USE TYPEWRITER OR BALL
POINT PEN-PRESS FIRMLY,
PRINT CLEARLY.

WATER WELL RECORD
KSA 82a-1201-1215

Kansas Department of Health and
Environment-Division of Environment
(Water well Contractors)
Topeka, Kansas 66620

1. Location of well:		County Wichita	Fraction NW 1/4 SW 1/4 SW 1/4	Section number 18	Township number T 16 S R 35 E	Range number 35
2. Distance and direction from nearest town or city: 12N, 1W, 1/4N of Street address of well location if in city: Marienthal, KS				3. Owner of well: Ralph Miller R.R. or street: Box 59 City, state, zip code: Marienthal, KS 67863		
4. Locate with "X" in section below: N W E S 1 Mile Sketch map: 				6. Bore hole dia. 26 in. Completion date 11-29-75 Well depth 170 ft.		
5. Type and color of material				7. <input type="checkbox"/> Cable tool <input type="checkbox"/> Rotary <input type="checkbox"/> Driven <input type="checkbox"/> Dug <input type="checkbox"/> Hollow rod <input type="checkbox"/> Jetted <input type="checkbox"/> Bored <input checked="" type="checkbox"/> Reverse rotary		
				8. Use: <input type="checkbox"/> Domestic <input type="checkbox"/> Public supply <input type="checkbox"/> Industry <input checked="" type="checkbox"/> Irrigation <input type="checkbox"/> Air conditioning <input type="checkbox"/> Stock <input type="checkbox"/> Lawn <input type="checkbox"/> Oil field water <input type="checkbox"/> Other		
				9. Casing: Material Steel Height: Above or below Threaded <input type="checkbox"/> Welded <input checked="" type="checkbox"/> Surface 10 in. RMP 16 PVC 170 Weight 31.67 lbs./ft. Dia. 16 in. to 170 ft. depth Wall Thickness: inches or Dia. 16 in. to 170 ft. depth gage No. 188		
				10. Screen: Manufacturer's name Free Flow Type Prime Steel Dia. 16 in. Slot/gauze 125 Length 30 ft. Set between 140 ft. and 170 ft. _____ ft. and _____ ft. Gravel pack? yes Size range of material 3/4-1		
				11. Static water level: _____ mo./day/yr. 112 ft. below land surface Date 10-24-75		
Clay				0	27	12. Pumping level below land surfaces: 143 ft. after 4 hrs. pumping 1000 g.p.m. 145 ft. after 4 hrs. pumping 1080 g.p.m. Estimated maximum yield 1080 g.p.m.
Gyp & Sd				27	34	13. Water sample submitted: _____ mo./day/yr. Yes <input checked="" type="checkbox"/> No <input type="checkbox"/> Date _____
Clay				34	37	14. Well head completion: <input type="checkbox"/> Pitless adapter 12 inches above grade
Sd med				37	45	15. Well grouted? <input checked="" type="checkbox"/> With: <input type="checkbox"/> Neat cement <input type="checkbox"/> Bentonite <input checked="" type="checkbox"/> Concrete Depth: From 0 ft. to 10 ft.
Gyp				45	60	16. Nearest source of possible contamination: ft. 3960 Direction E Type Septic Well disinfected upon completion? <input checked="" type="checkbox"/> Yes <input type="checkbox"/> No
Clay				60	66	17. Pump: _____ Not installed Manufacturer's name Western Land Roller Model number _____ HP _____ Volts _____ Length of drop pipe 160 ft. capacity 1080 g.p.m. Type: <input type="checkbox"/> Submersible <input checked="" type="checkbox"/> Turbine <input type="checkbox"/> Jet <input type="checkbox"/> Reciprocating <input type="checkbox"/> Centrifugal <input type="checkbox"/> Other
Med sd				66	85	20. Water well contractor's certification: This well was drilled under my jurisdiction and this report is true to the best of my knowledge and belief. Weishaar Drilling 232 Business name _____ License No. _____ Address Scott City, KS 67871 Signature [Signature] Date 7-20-76 Authorized representative
Clay				85	97	
Sd coarse				97	107	
Fine sd clay				107	125	
E Fine sd T				125	137	
Sd coarse				137	160	
Clay yellow				160	170	
Shale				170		
(Use a second sheet if needed)						
18. Elevation:		19. Remarks:				
Topography: <input type="checkbox"/> Hill <input checked="" type="checkbox"/> Slope <input type="checkbox"/> Upland <input type="checkbox"/> Valley						

Forward the white, blue and pink copies to the Department of Health and Environment

Form WWC-5