USE TYPEWRITER OR BALL POINT PEN-PRESS FIRMLY, PRINT CLEARLY.

WATER WELL RECORD
KSA 82a-1201-1215

Kansas Department of Health and Environment-Division of Environment
(Water well Contractors)
Topeka, Kansas 66620

1. Location of well:	County	Fraction	Section number	Township number	Range number
	Wichita	SW 1/4 NW 1/4 NW 1/4	34	T 16 S	R 36 E (W)

2. Distance and direction from nearest town or city: 5N, 3W, 5N, 1W,
Street address of well location if in city: ½S of Marienthal, Kansas

3. Owner of well: Miller Bros. % Wilbert Koehn
R.R. or street: RFD #1 - Box 60
City, state, zip code: Marienthal, Kansas 67863

4. Locate with "X" in section below:

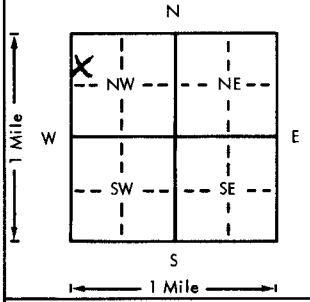

Sketch map:

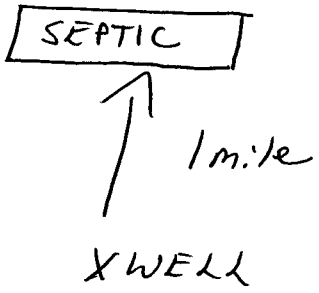

6. Bore hole dia. 26 in. Completion date
Well depth 200 ft. 3-25-77

7. __ Cable tool __ Rotary __ Driven __ Dug
__ Hollow rod __ Jetted __ Bored X Reverse rotary

8. Use: __ Domestic __ Public supply __ Industry
X Irrigation __ Air conditioning __ Stock
__ Lawn __ Oil field water __ Other

9. Casing: Material Steel Height: (Above) or below
Threaded __ Welded X Surface 10 in.
RMP __ PVC __ Weight 31.67 lbs./ft.
Dia. 16 in. to 200 ft. depth Wall Thickness: inches or
Dia. __ in. to __ ft. depth gage No. .188

5. Type and color of material	From	To
Clay	0	25
Gyp	25	32
Clay 'sdy'	32	60
Fine sd clay	60	67
Sd coarse	67	76
Fine sd clay	76	95
Sd coarse	95	105
Fine sd clay	105	140
Fine sd good	140	150
Fine sd	150	159
Sd rock	159	163
Fine sd clay	163	188
Clay	188	192
Sd coarse	192	197
Clay yellow	197	200
Shale (Use a second sheet if needed)	200	

10. Screen: Manufacturer's name Johnson & Free Flow
Type Galv. & Prime Steel Dia. 16 in.
Slot/gauze .100 & .125 Length 40 ft.
Set between 160 ft. and 200 ft.
ft. and ft.
Gravel pack? yes Size range of material 3/4-1½

11. Static water level: mo./day/yr.
125 ft. below land surface Date 3-25-77

12. Pumping level below land surfaces:
158 ft. after 4 hrs. pumping 550 g.p.m.
169 ft. after 4 hrs. pumping 850 g.p.m.
Estimated maximum yield 850 g.p.m.

13. Water sample submitted: mo./day/yr.
__ Yes X No Date

14. Well head completion:
__ Pitless adapter ____ Inches above grade

15. Well grouted? yes
With: X Neat cement __ Bentonite __ Concrete
Depth: From 0 ft. to 10 ft.

16. Nearest source of possible contamination:
ft. 5280 Direction North Type Septic
Well disinfected upon completion? X Yes __ No

17. Pump: X Not installed
Manufacturer's name
Model number HP Volts
Length of drop pipe ft. capacity g.p.m.
Type:
__ Submersible __ Turbine
__ Jet __ Reciprocating
__ Centrifugal __ Other

18. Elevation:
Topography:
__ Hill
__ Slope
X Upland
__ Valley

19. Remarks:
Well not completed by us.

20. Water well contractor's certification:
This well was drilled under my jurisdiction and this report is true to the best of my knowledge and belief.
Weishaar Drilling 232
Business name License No.
Address Scott City, KS 67871
Signed Authorized representative Date 6-7-77

Forward the white, blue and pink copies to the Department of Health and Environment

Form WWC-5

T 16 R 36 E (W) Sec 34 1/4 1/4 1/4

MI-1023