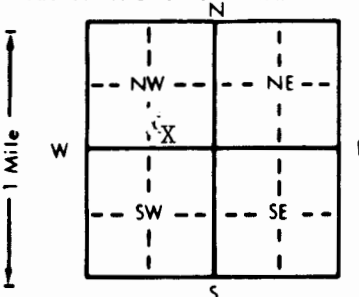


1 LOCATION OF WATER WELL: County: Wichita Fraction SW 1/4 SE 1/4 NW 1/4 Section Number 8 Township Number T 16 S Range Number R 37 E/W

Distance and direction from nearest town or city street address of well if located within city?
4 west 13 north 1/4 east from Leoti

2 WATER WELL OWNER: EL Brown
 RR#, St. Address, Box # : RR1 Box 34 Board of Agriculture, Division of Water Resources
 City, State, ZIP Code : Leoti, KS 67861 Application Number: 10879&25190

3 LOCATE WELL'S LOCATION WITH AN "X" IN SECTION BOX:

 4 DEPTH OF COMPLETED WELL: 190 ft. ELEVATION: 3400
 Depth(s) Groundwater Encountered 1. 150 ft. 2. _____ ft. 3. _____ ft.
 WELL'S STATIC WATER LEVEL 150 ft. below land surface measured on mo/day/yr
 Pump test data: Well water was 170 ft. after 1 hours pumping 140 gpm
 Est. Yield 200 gpm: Well water was 180 ft. after 1 hours pumping 175 gpm
 Bore Hole Diameter: 26 in. to _____ ft., and _____ in. to _____ ft.
 WELL WATER TO BE USED AS: 5 Public water supply 8 Air conditioning 11 Injection well
 1 Domestic 3 Feedlot 6 Oil field water supply 9 Dewatering 12 Other (Specify below)
 2 Irrigation 4 Industrial 7 Lawn and garden only 10 Monitoring well
 Was a chemical/bacteriological sample submitted to Department? Yes _____ No X; If yes, mo/day/yr sample was submitted
 Water Well Disinfected? Yes X No _____

5 TYPE OF BLANK CASING USED: 5 Wrought iron 8 Concrete tile CASING JOINTS: Glued X Clamped _____
 1 Steel 3 RMP (SR) 6 Asbestos-Cement 9 Other (specify below) Welded _____
 2 PVC 4 ABS 7 Fiberglass _____ Threaded _____
 Blank casing diameter 16 in. to 190 ft., Dia _____ in. to _____ ft., Dia _____ in. to _____ ft.
 Casing height above land surface 12 in., weight _____ lbs./ft. Wall thickness or gauge No. SDR26
 TYPE OF SCREEN OR PERFORATION MATERIAL: 7 PVC 10 Asbestos-cement
 1 Steel 3 Stainless steel 5 Fiberglass 8 RMP (SR) 11 Other (specify) _____
 2 Brass 4 Galvanized steel 6 Concrete tile 9 ABS 12 None used (open hole)
 SCREEN OR PERFORATION OPENINGS ARE: 5 Gauzed wrapped 8 Saw cut 11 None (open hole)
 1 Continuous slot 3 Mill slot 6 Wire wrapped 9 Drilled holes
 2 Louvered shutter 4 Key punched 7 Torch cut 10 Other (specify) _____
 SCREEN-PERFORATED INTERVALS: From 150 ft. to 190 ft., From _____ ft. to _____ ft.
 From _____ ft. to _____ ft., From _____ ft. to _____ ft.
 GRAVEL PACK INTERVALS: From 20 ft. to 190 ft., From _____ ft. to _____ ft.
 From _____ ft. to _____ ft., From _____ ft. to _____ ft.

6 GROUT MATERIAL: 1 Neat cement 2 Cement grout 3 Bentonite 4 Other _____
 Grout intervals: From 0 ft. to 20 ft., From _____ ft. to _____ ft., From _____ ft. to _____ ft.
 What is the nearest source of possible contamination:
 1 Septic tank 4 Lateral lines 7 Pit privy 10 Livestock pens 14 Abandoned water well
 2 Sewer lines 5 Cess pool 8 Sewage lagoon 11 Fuel storage 15 Oil well/Gas well
 3 Watertight sewer lines 6 Seepage pit 9 Feedyard 12 Fertilizer storage 16 Other (specify below)
 13 Insecticide storage
 Direction from well? West How many feet? 290

FROM	TO	LITHOLOGIC LOG	FROM	TO	PLUGGING INTERVALS
0	16	Fine sand and sandy clay			
16	32	Cliche			
32	49	Cliche (hard)			
49	65	Sand and sandy clay			
65	82	Sandy clay			
82	98	Sand and little cliche and clay			
98	114	Sand and sandy clay medium			
114	132	Sand and little clay medium			
132	147	Sand med to coarse and 6' clay			
147	158	Sandy clay			
158	164	Sand fine to medium			
164	180	Sand med and 1' clay			
180	181	Sand med to coarse			
181	189	Yellow clay			
189	196	Shale			

7 CONTRACTOR'S OR LANDOWNER'S CERTIFICATION: This water well was (1) constructed, (2) reconstructed, or (3) plugged under my jurisdiction and was completed on (mo/day/year) 5-15-96 and this record is true to the best of my knowledge and belief. Kansas Water Well Contractor's License No. KS 473 This Water Well Record was completed on (mo/day/yr) 5-22-96 under the business name of Tyler Water Well Service Inc. by (signature) [Signature]

OFFICE USE ONLY T R E/W SEC. 1/4 1/4 1/4