


|   |                                      |                          |                             |                            |
|---|--------------------------------------|--------------------------|-----------------------------|----------------------------|
| <b>1 LOCATION OF WATER WELL:</b><br>County: <u>greely</u> | Fraction <u>SW 1/4 NE 1/4 SE 1/4</u> | Section Number <u>12</u> | Township Number <u>16 3</u> | Range Number <u>39</u> E/W |
|---|--------------------------------------|--------------------------|-----------------------------|----------------------------|

Distance and direction from nearest town or city street address of well if located within city?

14 south of Wallace

|  |   |
|--|---|
| <b>2 WATER WELL OWNER:</b> <u>Daniel Larson</u><br>RR#, St. Address, Box #: <u>195 Rd 26</u><br>City, State ZIP Code: <u>Sharon Springs KS 67758</u> | <b>Global Positioning Systems</b> (decimal degrees, min. of 4 digits)<br>Latitude: <u>38.673458</u><br>Longitude: <u>-101.569789</u><br>Elevation: _____<br>Datum: <u>NAD 83</u><br>Data Collection Method: <u>Handheld</u> |
|--|---|

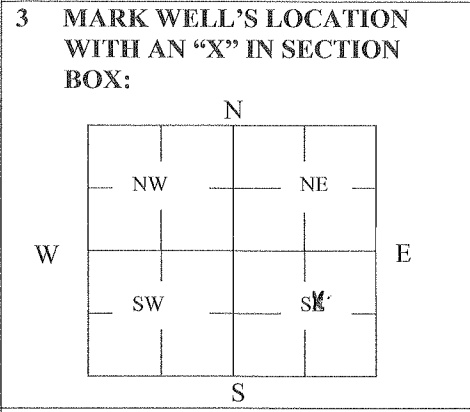

**4 DEPTH OF WELL** 110 ft.

WELL'S STATIC WATER LEVEL 214 ft

WELL WAS USED AS:

|              |                            |                             |
|--------------|----------------------------|-----------------------------|
| 1 Domestic   | 5 Public Water Supply      | 9 Dewatering                |
| 2 Irrigation | 6 Oil Field Water Supply   | 10 Monitoring               |
| 3 Feedlot    | 7 Domestic (Lawn & Garden) | 11 Injection Well           |
| 4 Industrial | 8 Air Conditioning         | 12 Other <u>L. bog dock</u> |

Was a chemical/bacteriological sample submitted to Department? Yes \_\_\_\_\_ No X

**5 TYPE OF BLANK CASING USED:**

|              |            |                   |                 |                         |
|--------------|------------|-------------------|-----------------|-------------------------|
| 1 Steel      | 3 RMP (SR) | 5 Wrought         | 7 Fiberglass    | 9 Other (Specify below) |
| <u>2 PVC</u> | 4 ABS      | 6 Asbestos-Cement | 8 Concrete Tile | _____                   |

Blank casing diameter 5" in. Was casing pulled? Yes \_\_\_\_\_ No X If yes, how much \_\_\_\_\_

Casing height above or below land surface -1 in.

**6 GROUT PLUG MATERIAL:** 1 Neat cement 2 Cement grout 3 Bentonite 4 Other \_\_\_\_\_

Grout Plug Intervals: From 0 ft. to 20 ft., From \_\_\_\_\_ ft. to \_\_\_\_\_ ft., From \_\_\_\_\_ to \_\_\_\_\_ ft.

What is the nearest source of possible contamination:

|                          |                   |                                |                               |
|--------------------------|-------------------|--------------------------------|-------------------------------|
| 1 Septic tank            | 6 Seepage pit     | 11 Fuel Storage                | 16 Other (specify below)      |
| 2 Sewer lines            | 7 Pit privy       | 12 Fertilizer storage          | _____                         |
| 3 Watertight sewer lines | 8 Sewage lagoon   | 13 Insecticide storage         | _____                         |
| 4 Lateral lines          | 9 Feedyard        | <u>14 Abandoned water well</u> | Direction from well? <u>W</u> |
| 5 Cess pool              | 10 Livestock pens | 15 Oil well/Gas well           | How many feet? <u>20</u>      |

| FROM | TO  | PLUGGING MATERIALS | FROM | TO | PLUGGING MATERIALS |
|------|-----|--------------------|------|----|--------------------|
| 0    | 20  | cement             |      |    |                    |
| 20   | 110 | clay               |      |    |                    |
|      |     |                    |      |    |                    |
|      |     |                    |      |    |                    |
|      |     |                    |      |    |                    |
|      |     |                    |      |    |                    |

**7 CONTRACTOR'S OR LANDOWNER'S CERTIFICATION:** This water well was plugged under my jurisdiction and was completed on (mo/day/year) 5-4-12 and this record is true to the best of my knowledge and belief. Kansas Water Well Contractor's License No. 213. This Water Well Record was completed on (mo/day/year) 5-7-12 under the business name of Kemp's Well Service by (signature) [Signature]

**INSTRUCTIONS:** Use typewriter or ballpoint pen. Please press firmly and print clearly. Please fill in blanks, underline or circle the correct answers. Send top three copies to Kansas Department of Health and Environment, Bureau of Water, Geology Section, 1000 SW Jackson St., Ste. 420, Topeka, Kansas 66612-1367. Telephone: 785/296-5522. Send one to Water Well Owner and retain one for your records. Visit us at <http://www.kdheks.gov/geo/waterwells>.