USE TYPEWRITER OR BALL POINT PEN-PRESS FIRMLY, PRINT CLEARLY.

WATER WELL RECORD
KSA 82a-1201-1215

Kansas Department of Health and Environment-Division of Environment
(Water well Contractors)
Topeka, Kansas 66620

1. Location of well:	County	Fraction	Section number	Township number	Range number
	Wichita	N/W 1/4 N/W 1/4 S/E 1/4	26	T 16 S	R 37 E/W

2. Distance and direction from nearest town or city:
10½ N., ½ W. of Leoti, Kansas
Street address of well location if in city:

3. Owner of well:
R.R. or street:
City, state, zip code:
Norman Ames
Leoti, Kansas 67861

4. Locate with "X" in section below:

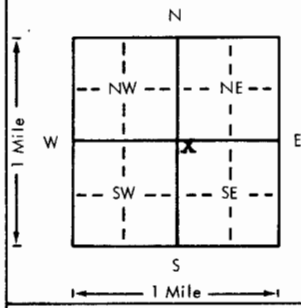

Sketch map:

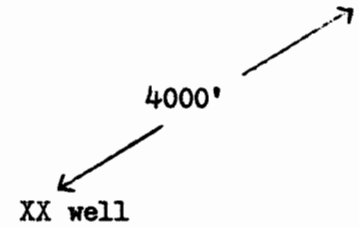

6. Bore hole dia. 26 in. Completion date
Well depth 215 ft. 4-10-1978

7. __ Cable tool __ Rotary __ Driven __ Dug
__ Hollow rod __ Jetted __ Bored X Reverse rotary

8. Use: __ Domestic __ Public supply __ Industry
X Irrigation __ Air conditioning __ Stock
__ Lawn __ Oil field water __ Other

9. Casing: Material Steel Height: Above or below
Threaded ___ Welded X Surface 10 in.
RMP ___ PVC ___ Weight 31.67 lbs./ft.
Dia. 16 in. to 175 ft. depth Wall Thickness: inches or
Dia. ___ in. to ___ ft. depth gage No. .188

5. Type and color of material	From	To
Clay	0	36
sand coarse	36	41
sandy clay	41	45
gyp rock	45	55
~~fine sand clay~~ T	~~55~~	~~66~~
sand coarse	66	85
fine sand clay	85	111
sand coarse	111	116
clay	116	120
~~sand coarse~~	~~120~~	~~135~~
fine sand clay	135	145
~~sand coarse~~	~~145~~	~~158~~
rock H	158	161
fine sand	161	172
~~sand coarse~~	~~172~~	~~180~~
fine sand good	180	195
~~sand coarse~~	~~195~~	~~212~~
clay yellow	212	225
shale	225	

(Use a second sheet if needed)

10. Screen: Manufacturer's name Cook & Free Flow
Type Galv.&steel Dia. 16"
Slot/gauze 1/16" Length 40'
Set between 175 ft. and 215 ft.
___ ft. and ___ ft.
Gravel pack? yes Size range of material 3/4 down

11. Static water level: mo./day/yr.
140 ft. below land surface Date 4-10-78

12. Pumping level below land surfaces: MK
168 ft. after 2 hrs. pumping 560 g.p.m.
178 ft. after 2 hrs. pumping 700 g.p.m.
Estimated maximum yield 700 g.p.m.

13. Water sample submitted: mo./day/yr.
___ Yes X No Date

14. Well head completion: NA
___ Pitless adapter ___ Inches above grade

15. Well grouted? yes
With: X Neat cement ___ Bentonite ___ Concrete
Depth: From 0 ft. to 10 ft.

16. Nearest source of possible contamination:
ft. 4000 Direction N/E Type Septic
Well disinfected upon completion? X Yes ___ No

17. Pump: X Not installed
Manufacturer's name
Model number HP Volts
Length of drop pipe ft. capacity g.p.m.
Type:
___ Submersible ___ Turbine
___ Jet ___ Reciprocating
___ Centrifugal ___ Other

18. Elevation:

Topography:
___ Hill
___ Slope
X Upland
___ Valley

19. Remarks:
Well not completed by us.

20. Water well contractor's certification:
This well was drilled under my jurisdiction and this report is true to the best of my knowledge and belief.
Weishaar Drilling & Supp 232
Business name License No.
Address Scott City, KS 67871
Signed Authorized Representative Date 5/9/78

Forward the white, blue and pink copies to the Department of Health and Environment

Form WWC-5

MI-1023

T 16 R 37 E/W Sec 26 1/4 1/4 1/4 NW NE SE