


WATER WELL RECORD Form WWC-5 KSA 82a-1212

1 LOCATION OF WATER WELL: Fraction Section Number Township Number Range Number
 COUNTY: 102 WICHITA NW 1/4 NW 1/4 SE 1/4 06 T 16 S R 38 W

Distance and direction from nearest town or city street address of well if located within city?
 FROM LEOTI; 15 MILES NORTH & 10 3/4 WEST

2 WATER WELL OWNER: MARSHALL WOODBURY TRUST
 RR#, St. Address, Box #: PO BOX 5406 Board of Agriculture, Division of Water Resources
 City, State, ZIP code: CAVE CREEK, AZ 85331-5406 Application Number: 10960, 10199 & 8277

3 LOCATE WELL'S LOCATION WITH AN "X" IN SECTION BOX:

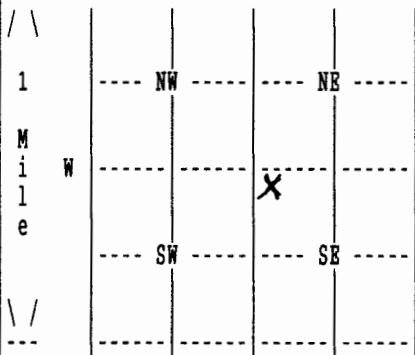

4 DEPTH OF COMPLETED WELL 247 ELEVATION: 0
 Depth(s) Groundwater Encountered 1. 0 ft. 2. 0 ft. 3. 0 ft.

WELL'S STATIC WATER LEVEL 175 ft. below land surface measured on mo/day/yr 05/13/05
 Pump test data: Well water was 208 ft. after 4 hours pumping 900 gpm

Estimated Yield 0 gpm: Well water was 0 ft. after 0 hours pumping 0 gpm

Bore Hole Diameter 24 in. to 247 ft., and in. to 0 ft.

WELL WATER TO BE USED AS: 02 IRRIGATION

Was a chemical/bacteriological sample submitted to department? No ;
 If yes, mo/day/yr sample was submitted Water well disinfected? Yes

5 TYPE OF BLANK CASING USED: 01 STEEL CASING JOINTS: WELDED
 Blank casing diameter 16 in. to 247 ft., Dia in. to 0 ft., Dia in. to 0 ft.
 Casing height above land surface 12 in., weight 42 lbs/ft. Wall thickness or gauge No. .250
 TYPE OF SCREEN OR PERFORATION MATERIAL: 01 STEEL
 SCREEN OR PERFORATION OPENINGS ARE: 01 CONT. SLOT

SCREEN PERFORATED INTERVALS: From 188 ft. to 228 ft., From 0 ft. to 0 ft.
 From 0 ft. to 0 ft., From 0 ft. to 0 ft.
 GRAVEL PACK INTERVALS: From 20 ft. to 247 ft., From 0 ft. to 0 ft.
 From 0 ft. to 0 ft., From 0 ft. to 0 ft.

6 GROUT MATERIAL 03 BENTONITE
 Grout Intervals: From 0 ft. to 20 ft., From 0 ft. to 0 ft., From 0 ft. to 0 ft.
 What is the nearest source of possible contamination: 14 ABAND. WELL
 Direction from well? NORTH How many feet? 50

FROM	TO	LITHOLOGIC LOG	FROM	TO	PLUGGING INTERVALS
0	2	02 SILT			
2	49	04 SANDY CLAY 20 LIMESTONE			
49	108	05 SAND 11 GRAVEL 01 CLAY			
108	124	04 SANDY CLAY 05 SAND			
124	180	05 SAND 13 FINE GRAVEL			
180	185	04 SANDY CLAY			
185	228	05 SAND			
228	240	31 CALICHE			

7 CONTRACTOR'S OR LANDOWNER'S CERTIFICATION: This water well was Constructed under my jurisdiction and was completed on (mo/day/year) 05/11/05 and this record is true to the best of my knowledge and belief. Kansas Water Well Contractor's License No. 145 This Water Well Record was completed on (mo/day/yr) 06/16/05 under the business name of HENKLE DRILLING & SUPPLY by (signature) *Bruce J. Reichardt*