

WATER WELL RECORD

Form WWC-5

Division of Water Resources App. No.


20356

1 LOCATION OF WATER WELL: County: Wichita	Fraction ¼ NW ¼ SW ¼ NW ¼	Section Number 10	Township No. T 16 S	Range Number R 38 <input type="checkbox"/> E <input checked="" type="checkbox"/> W
---	------------------------------	----------------------	------------------------	---

Street/Rural Address of Well Location; if unknown, distance & direction from nearest town or intersection: If at owner's address, check here approx 14 miles northwest of Leoti, KS

Global Positioning System (GPS) information:
 Latitude: .38,68006 (in decimal degrees)
 Longitude: 101,51326 (in decimal degrees)
 Elevation: 3467
 Datum: WGS 84, NAD 83, NAD 27
 Collection Method:
 GPS unit (Make/Model:)
 Digital Map/Photo, Topographic Map, Land Survey
 Est. Accuracy: <3 m, 3-5 m, 5-15 m, >15 m

2 WATER WELL OWNER: Marshall Woodbury Trust
 RR#, Street Address, Box #: PO Box 67168
 City, State, ZIP Code : Phoenix, AZ 85082

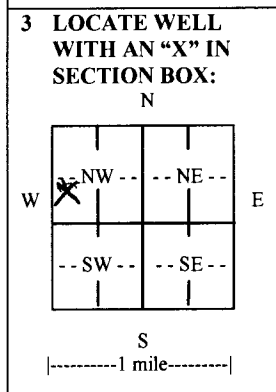

4 DEPTH OF COMPLETED WELL 241 ft.

Depth(s) Groundwater Encountered (1)..... ft. (2)..... ft. (3)..... ft.
 WELL'S STATIC WATER LEVEL...179.....ft. below land surface measured on mo/day/yr. 5/17/11.....
 Pump test data: Well water was 211.....ft. after 4..... hours pumping 574..... gpm
 EST. YIELD.....gpm. Well water was.....ft. after..... hours pumping..... gpm
 Bore Hole Diameter 24.....in. to 241.....ft., andin. toft.
 WELL WATER TO BE USED AS: Public water supply Geothermal Injection well
 Domestic Feedlot Oil field water supply Dewatering Other (Specify below)
 Irrigation Industrial Domestic-lawn & garden Monitoring well
 Was a chemical/bacteriological sample submitted to Department? Yes No
 If yes, mo/day/yr sample was submitted.....
 Water well disinfected? Yes No

5 TYPE OF CASING USED: Steel PVC Other

CASING JOINTS: Glued Clamped Welded Threaded
 Casing diameter .16..... in. to .241..... ft., Diameter in. to ft., Diameter in. to ft.
 Casing height above land surface...12..... in., Weight 42.09.....lbs./ft., Wall thickness or gauge No. .0.250.....
 TYPE OF SCREEN OR PERFORATION MATERIAL:
 Steel Stainless Steel PVC Other (Specify)
 Brass Galvanized Steel None used (open hole)
 SCREEN OR PERFORATION OPENINGS ARE:
 Continuous slot Mill slot Gauze wrapped Torch cut Drilled holes None (open hole)
 Louvered shutter Key punched Wire wrapped Saw cut Other (specify)
 SCREEN-PERFORATED INTERVALS: From...181..... ft. to ...221..... ft., From ft. to ft.
 From..... ft. to ft., From ft. to ft.
 GRAVEL PACK INTERVALS: From...20..... ft. to 241..... ft., From ft. to ft.
 From..... ft. to ft., From ft. to ft.

6 GROUT MATERIAL: Neat cement Cement grout Bentonite Other

Grout Intervals: From .0..... ft. to 20..... ft., From ft. to ft., From ft. to ft.
 What is the nearest source of possible contamination:
 Septic tank Lateral lines Pit privy Livestock pens Insecticide storage Other (specify below)
 Sewer lines Cesspool Sewage lagoon Fuel storage Abandoned water well
 Watertight sewer lines Seepage pit Feedyard Fertilizer storage Oil well/gas well **None Detected**
 Direction from well Distance from well

FROM	TO	LITHOLOGIC LOG	FROM	TO	LITHO. LOG (cont.) or PLUGGING INTERVALS
0	2	top soil	221	229	yellow clay and black shale
2	18	brown sandy clay	229	241	black shale
18	23	sandy clay & calicho			
23	56	calicho & lime rock			
82	96	fine to med sand, some coarse			
96	118	brn sdy cly some gy cly calicho bed			
118	143	fine to med sand & med coarse			
143	158	fine to med sand, some clay ledges			
158	172	fne snd some md yllw + brwn cly mix			
172	221	fine to med & sm coarse grvl mix			

7 CONTRACTOR'S OR LANDOWNER'S CERTIFICATION: This water well was constructed, reconstructed, or plugged under my jurisdiction and was completed on (mo/day/year) 5/17/11..... and this record is true to the best of my knowledge and belief. Kansas Water Well Contractor's License No. 145..... This Water Well Record was completed on (mo/day/year) 6/10/11..... under the business name of Hydro Resources..... by (signature) *Blaine J. Kelly*

INSTRUCTIONS: Use typewriter or ball point pen. PLEASE PRESS FIRMLY and PRINT clearly. Please fill in blanks and check the correct answers. Send three copies (white, blue, pink) to Kansas Department of Health and Environment, Bureau of Water, Geology Section, 1000 SW Jackson St., Suite 420, Topeka, Kansas 66612-1367. Telephone 785-296-5522. Send one copy to WATER WELL OWNER and retain one for your records. Include fee of \$5.00 for each constructed well. Visit us at <http://www.kdheks.gov/waterwell/index.html>.