


**WATER WELL PLUGGING RECORD Form WWC-5P KSA 82a-1212 ID NO.**

**1 LOCATION OF WATER WELL:** County: Wichita Fraction: SW 1/4 Section Number: 32 Township Number: 16S Range Number: 30 **W**  
 Distance and direction from nearest town or city street address of well if located within city?

**2 WATER WELL OWNER:** Joseph F. Bauck Jr. Trust  
Lisha A. Bauck Trust  
 RR#, St. Address, Box #: 646 N. County Rd 6  
 City, State ZIP Code: Leoti, KS 67861  
**Global Positioning Systems (decimal degrees, min. of 4 digits)**  
 Latitude: \_\_\_\_\_  
 Longitude: \_\_\_\_\_  
 Elevation: \_\_\_\_\_  
 Datum: \_\_\_\_\_  
 Data Collection Method: \_\_\_\_\_

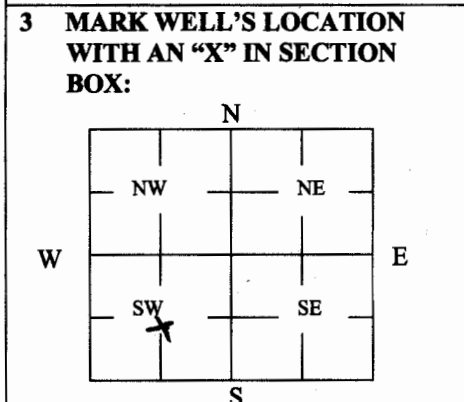

**4 DEPTH OF WELL** 157 ft.  
 WELL'S STATIC WATER LEVEL 12 ft.  
 WELL WAS USED AS:  
 1 Domestic  5 Public Water Supply  9 Dewatering   
 2 Irrigation  6 Oil Field Water Supply  10 Monitoring   
 3 Feedlot  7 Domestic (Lawn & Garden)  11 Injection Well   
 4 Industrial  8 Air Conditioning  12 Other \_\_\_\_\_  
 Was a chemical/bacteriological sample submitted to Department? Yes \_\_\_\_\_ No

**5 TYPE OF BLANK CASING USED:**  
 Steel  3 RMP (SR)  5 Wrought  7 Fiberglass  9 Other (Specify below) \_\_\_\_\_  
 2 PVC  4 ABS  6 Asbestos-Cement  8 Concrete Tile \_\_\_\_\_  
 Blank casing diameter 16 in. Was casing pulled? Yes  No \_\_\_\_\_ If yes, how much 52"  
 Casing height above or below land surface 52 in.

**6 GROUT PLUG MATERIAL:** 1 Neat cement 2 Cement grout  Bentonite 4 Other \_\_\_\_\_  
 Grout Plug Intervals: From 157 ft. to 6 ft., From 6 ft. to 3.5 ft., From 3.5 to 0.0 ft.  
 What is the nearest source of possible contamination:  
 Septic tank  6 Seepage pit  11 Fuel Storage  16 Other (specify below) \_\_\_\_\_  
 2 Sewer lines  7 Pit privy  12 Fertilizer storage \_\_\_\_\_  
 3 Watertight sewer lines  8 Sewage lagoon  13 Insecticide storage \_\_\_\_\_  
 4 Lateral lines  9 Feedyard  14 Abandoned water well  Direction from well? W  
 5 Cess pool  10 Livestock pens  15 Oil well/Gas well  How many feet? 1625F

FROM	TO	PLUGGING MATERIALS	FROM	TO	PLUGGING MATERIALS
157	6	Sand			
6	3.5	Bentonite			
3.5	0.0	Dirt			

**7 CONTRACTOR'S OR LANDOWNER'S CERTIFICATION:** This water well was plugged under my jurisdiction and was completed on (mo/day/year) 11-24-2012 and this record is true to the best of my knowledge and belief. Kansas Water Well Contractor's License No. \_\_\_\_\_ This Water Well Record was completed on (mo/day/year) 11-24-2012 under the business name of Jones Construction by (signature) [Signature]

**INSTRUCTIONS:** Use typewriter or ballpoint pen. Please press firmly and print clearly. Please fill in blanks, underline or circle the correct answers. Send top three copies to Kansas Department of Health and Environment, Bureau of Water, Geology Section, 1000 SW Jackson St., Ste. 420, Topeka, Kansas 66612-1367. Telephone: 785/296-5522. Send one to Water Well Owner and retain one for your records. Visit us at <http://www.kdheks.gov/geo/waterwells>.