


n well

WATER WELL PLUGGING RECORD Form WWC-5P KSA 82a-1212 ID NO. []

1 LOCATION OF WATER WELL: Fraction 1/4 NW 1/4 Section Number 32 Township Number T 16 S Range Number 32 E W

Street/Rural Address of Well Location; if unknown, distance & direction from nearest town or intersection: If at owner's address, check here Global Positioning Systems (GPS) information: Latitude: _____ (in decimal degrees) Longitude: _____ (in decimal degrees) Elevation: _____ Datum: WGS84, NAD83, NAD27 Collection Method: GPS unit (Make/Model): _____ Digital Map/Photo, Topographic Map, Land Survey Est. Accuracy: <3 m, 3-5 m, 5-15 m, > 15 m

2 WATER WELL OWNER: Jo Black JR RR#, St. Address, Box #: _____ City, State ZIP Code: _____

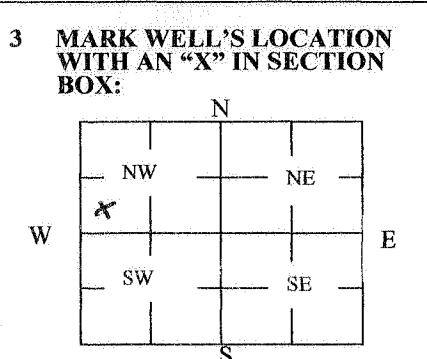

4 DEPTH OF WELL 192 ft. WELL'S STATIC WATER LEVEL 42 ft. WELL WAS USED AS: Domestic Public Water Supply Dewatering Irrigation Oil Field Water Supply Monitoring Feedlot Domestic (Lawn & Garden) Injection Well Industrial Air Conditioning Other _____ Was a chemical/bacteriological sample submitted to Department? Yes No

5 TYPE OF BLANK CASING USED: Steel RMP (SR) Wrought Fiberglass Other (Specify below) PVC ABS Asbestos-Cement Concrete Tile _____ Blank casing diameter 16 in. Was casing pulled? Yes No If yes, how much 50' Casing height above or below land surface 50' in.

6 GROUT PLUG MATERIAL: Neat cement Cement grout Bentonite Other _____ Grout Plug Intervals: From 192 ft. to 8 ft., From 8 ft. to 4 ft., From 4 ft. to 0 ft. What is the nearest source of possible contamination: Septic tank Seepage pit Fuel storage Other (specify below) Sewer lines Pit privy Fertilizer storage Watertight sewer lines Sewage lagoon Insecticide storage Lateral lines Feedyard Abandoned water well Oil well/Gas well Direction from well? SW Cess pool Livestock pens How many feet? 100'

FROM	TO	PLUGGING MATERIALS	FROM	TO	PLUGGING MATERIALS
192	8	sand			
8	4	Bentonite			
4	0	Dir			

7 CONTRACTOR'S OR LANDOWNER'S CERTIFICATION: This water well was plugged under my jurisdiction and was completed on (mo/day/year) 11-23-2013 and this record is true to the best of my knowledge and belief. Kansas Water Well Contractor's License No. _____ This Water Well Record was completed on (mo/day/year) 11-25-2013 under the business name of Jones Enterprises by (signature) [Signature]

INSTRUCTIONS: Use typewriter or ballpoint pen. Please press firmly and print clearly. Please fill in blanks, underline or circle the correct answers. Send top three copies to Kansas Department of Health and Environment, Bureau of Water, Geology Section, 1000 SW Jackson St., Ste. 420, Topeka, Kansas 66612-1367. Telephone: 785/296-5524. Send one to Water Well Owner and retain one for your records. Visit us at <http://www.kdheks.gov/waterwell/index.html>.