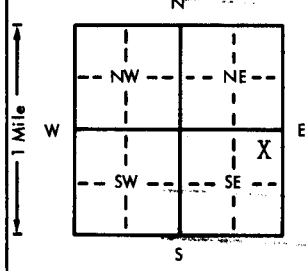


USE TYPEWRITER OR BALL
POINT PEN-PRESS FIRMLY,
PRINT CLEARLY.

WATER WELL RECORD
KSA 82a-1201-1215

Kansas Department of Health and
Environment-Division of Environment
(Water well Contractors)
Topeka, Kansas 66620

1. Location of well:		County Greeley	Fraction NE 1/4 NE 1/4 SE 1/4	Section number 6	Township number T 16	Range number S R 39 E/W
2. Distance and direction from nearest town or city: 16 mi. north, 5 mi. east, & 5/8 mi south Street address of well location if in city:				3. Owner of well: Heye Wilken R.R. or street: City, state, zip code: Leoti, Kans. 67861		
4. Locate with "X" in section below:		Sketch map:		6. Bore hole dia. 26 in. Completion date _____ Well depth 194 ft. 12-23-75		
				7. Cable tool _____ Rotary _____ Driven _____ Dug _____ Hollow rod _____ Jetted _____ Bored <input checked="" type="checkbox"/> Reverse rotary		
5. Type and color of material		From		To		8. Use: _____ Domestic _____ Public supply _____ Industry <input checked="" type="checkbox"/> Irrigation _____ Air conditioning _____ Stock _____ Lawn _____ Oil field water _____ Other
Overburden		0		90		9. Casing: Material steel Height: Above ground 16 ft. Threaded _____ Welded <input checked="" type="checkbox"/> Surface 12 in. RMP _____ PVC _____ Weight 40 lbs./ft. Dia. 16 in. to 14 1/4 ft. depth Wall Thickness: inches or Dia. _____ in. to _____ ft. depth gage No. 219
Sand & clay		90		150		10. Screen: Manufacturer's name _____ W. A. Brown Type Free Flo Dia. 16 Slot/gauze Slot Length 28 ft. Set between 14 1/4 ft. and 19 1/4 ft. _____ ft. and _____ ft. Gravel pack? yes Size range of material 5/8
Sand		150		187		11. Static water level: _____ mo./day/yr. 140 ft. below land surface Date 12-24-75
Clay		187		192		12. Pumping level below land surfaces: 160 ft. after 4 hrs. pumping 1300 g.p.m. _____ ft. after _____ hrs. pumping _____ g.p.m. Estimated maximum yield 2000 g.p.m.
Shale		192		194		13. Water sample submitted: _____ mo./day/yr. Yes <input checked="" type="checkbox"/> No _____ Date _____
						14. Well head completion: _____ Pitless adapter 18 inches above grade
						15. Well grouted? yes With: _____ Neat cement <input checked="" type="checkbox"/> Bentonite _____ Concrete _____ Depth: From 0 ft. to 10 ft.
						16. Nearest source of possible contamination: ft. _____ Direction _____ Type None Well disinfected upon completion? _____ Yes <input checked="" type="checkbox"/> No
						17. Pump: <input checked="" type="checkbox"/> Not installed Manufacturer's name _____ Model number _____ HP _____ Volts _____ Length of drop pipe _____ ft. capacity _____ g.p.m. Type: _____ Submersible _____ Turbine _____ Jet _____ Reciprocating _____ Centrifugal _____ Other
						20. Water well contractor's certification: This well was drilled under my jurisdiction and this report is true to the best of my knowledge and belief. ARK VALLEY PUMP & SUPPLY 123 Business name _____ License No. _____ Address Box 235 Holly, Colo Signed W. Smith Date 2-9-76 Authorized representative
18. Elevation:		19. Remarks:				
Topography: _____ Hill _____ Slope <input checked="" type="checkbox"/> Upland _____ Valley		Level				