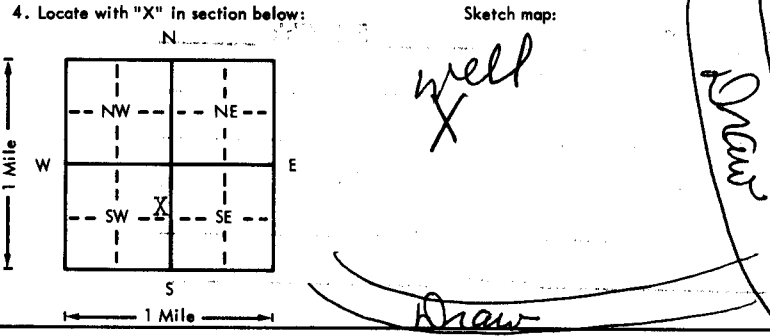


USE TYPEWRITER OR BALL POINT PEN-PRESS FIRMLY, PRINT CLEARLY.

SHARON SPRINGS
4 NW

WATER WELL RECORD
KSA 82a-1201-1215

Kansas Department of Health and Environment-Division of Environment
(Water well Contractors)
Topeka, Kansas 66620

1. Location of well: County: Greeley		Fraction: SE 1/4 NE 1/4 SW 1/4		Section number: 7	Township number: T 16 S R 39 E	Range number: 39
2. Distance and direction from nearest town or city: 14 1/2 N, 1/4 E Street address of well location if in city: of Whitelaw, KS				3. Owner of well: Alvin Wilkens R.R. or street: Leoti, KS 67861 City, state, zip code:		
4. Locate with "X" in section below: Sketch map: 				6. Bore hole dia. 9 in. Completion date: 1-14-76 Well depth: 175		
5. Type and color of material				7. <input checked="" type="checkbox"/> Cable tool <input checked="" type="checkbox"/> Rotary <input type="checkbox"/> Driven <input type="checkbox"/> Dug <input type="checkbox"/> Hollow rod <input type="checkbox"/> Jetted <input type="checkbox"/> Bored <input type="checkbox"/> Reverse rotary		
				8. Use: <input type="checkbox"/> Domestic <input type="checkbox"/> Public supply <input type="checkbox"/> Industry <input type="checkbox"/> Irrigation <input type="checkbox"/> Air conditioning <input checked="" type="checkbox"/> Stock <input type="checkbox"/> Lawn <input type="checkbox"/> Oil field water <input type="checkbox"/> Other		
				9. Casing: Material Plas , Height: Above or below Threaded <input type="checkbox"/> Welded Glue Surface 12 in. RMP <input checked="" type="checkbox"/> PVC <input type="checkbox"/> Weight: 1.8 lbs./ft. Dia. 5 in. to 155 ft. depth; Wall Thickness: inches or Dia. <input type="checkbox"/> in. to <input type="checkbox"/> ft. depth; gage No. .250		
				10. Screen: Manufacturer's name Jess & Lowell Type RMP Dia. 5 in. <input checked="" type="checkbox"/> gauze 1/16 Length 20 ft. Set between 155 ft. and 175 ft. ft. and <input type="checkbox"/> ft. Gravel pack? yes Size range of material 1/2-1/8		
				11. Static water level: <input type="checkbox"/> mo./day/yr. 103 ft. below land surface Date 1-12-76		
				12. Pumping level below land surfaces: 113 ft. after 1 hrs. pumping 4 g.p.m. ft. after <input type="checkbox"/> hrs. pumping <input type="checkbox"/> g.p.m. Estimated maximum yield 4 g.p.m.		
				13. Water sample submitted: <input type="checkbox"/> mo./day/yr. Yes <input checked="" type="checkbox"/> No <input type="checkbox"/> Date <input type="checkbox"/>		
				14. Well head completion: <input type="checkbox"/> Pitless adapter 12 inches above grade		
				15. Well grouted? yes With: <input checked="" type="checkbox"/> Neat cement <input type="checkbox"/> Bentonite <input type="checkbox"/> Concrete Depth: From 0 ft. to 15 ft.		
				16. Nearest source of possible contamination: ft. 100 Direction E Type Draw Well disinfected upon completion? <input checked="" type="checkbox"/> Yes <input type="checkbox"/> No		
				17. Pump: <input type="checkbox"/> Not installed Manufacturer's name Aermotor Model number <input type="checkbox"/> HP <input type="checkbox"/> Volts <input type="checkbox"/> Length of drop pipe 169 ft. capacity 4 g.p.m. Type: <input type="checkbox"/> Submersible <input type="checkbox"/> Turbine <input type="checkbox"/> Jet <input type="checkbox"/> Reciprocating <input type="checkbox"/> Centrifugal Windmill <input checked="" type="checkbox"/> Other		
18. Elevation:		19. Remarks: TOPO 8583 173		20. Water well contractor's certification: This well was drilled under my jurisdiction and this report is true to the best of my knowledge and belief. Weishaar Drilling 232 Business name License No. Address Spott, City, KS 67871 Signed [Signature] Date 1-11-76 Authorized representative		

T
R
S
SE
NW
E
W
1/4
1/4
1/4