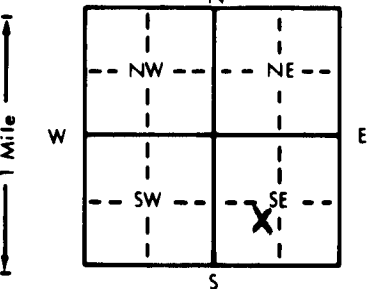


1 LOCATION OF WATER WELL:		Fraction NE 1/4 SW 1/4 SE 1/4		Section Number 7	Township Number T 16 S	Range Number R 39 E/W
County: Greeley						
Distance and direction from nearest town or city street address of well if located within city? 14 north, 5 east of Tribune, KS						
2 WATER WELL OWNER: Smith Ranch Cattle						
RR#, St. Address, Box #: Box 399						
City, State, ZIP Code: Tribune, KS 67879						
Board of Agriculture, Division of Water Resources Application Number:						
3 LOCATE WELL'S LOCATION WITH AN "X" IN SECTION BOX:		4 DEPTH OF COMPLETED WELL: 17 ft. ELEVATION: 3620				
<div style="text-align: center;"></div>		Depth(s) Groundwater Encountered 1. none ft. 2. ft. 3. ft.				
		WELL'S STATIC WATER LEVEL none ft. below land surface measured on mo/day/yr				
		Pump test data: Well water was ft. after hours pumping gpm				
		Est. Yield gpm: Well water was ft. after hours pumping gpm				
Bore Hole Diameter in. to ft. and in. to ft.						
WELL WATER TO BE USED AS:						
1 Domestic 3 Feedlot 5 Public water supply 8 Air conditioning 11 Injection well						
2 Irrigation 4 Industrial 6 Oil field water supply 9 Dewatering 12 Other (Specify below)						
7 Lawn and garden only 10 Monitoring well						
Was a chemical/bacteriological sample submitted to Department? Yes No; If yes, mo/day/yr sample was submitted						
Water Well Disinfected? Yes No X						
5 TYPE OF BLANK CASING USED:						
1 Steel 3 RMP (SR) 5 Wrought iron 8 Concrete tile CASING JOINTS: Glued Clamped X						
2 PVC 4 ABS 6 Asbestos-Cement 9 Other (specify below) Welded						
7 Fiberglass tin Threaded						
Blank casing diameter 5 in. to 17 ft. Dia in. to ft. Dia in. to ft.						
Casing height above land surface in. weight lbs./ft. Wall thickness or gauge No.						
TYPE OF SCREEN OR PERFORATION MATERIAL:						
1 Steel 3 Stainless steel 5 Fiberglass 7 PVC 10 Asbestos-cement						
2 Brass 4 Galvanized steel 6 Concrete tile 8 RMP (SR) 11 Other (specify)						
9 ABS 12 None used (open hole)						
SCREEN OR PERFORATION OPENINGS ARE:						
1 Continuous slot 3 Mill slot 5 Gauzed wrapped 8 Saw cut 11 None (open hole)						
2 Louvered shutter 4 Key punched 6 Wire wrapped 9 Drilled holes						
7 Torch cut 10 Other (specify)						
SCREEN-PERFORATED INTERVALS: From ft. to ft. From ft. to ft.						
From ft. to ft. From ft. to ft.						
GRAVEL PACK INTERVALS: From ft. to ft. From ft. to ft.						
From ft. to ft. From ft. to ft.						
6 GROUT MATERIAL: 1 Neat cement 2 Cement grout <u>3 Bentonite</u> 4 Other						
Grout Intervals: From ft. to ft. From ft. to ft. From ft. to ft.						
What is the nearest source of possible contamination:						
1 Septic tank 4 Lateral lines 7 Pit privy 10 Livestock pens 14 Abandoned water well						
2 Sewer lines 5 Cess pool 8 Sewage lagoon 11 Fuel storage 15 Oil well/Gas well						
3 Watertight sewer lines 6 Seepage pit 9 Feedyard 12 Fertilizer storage 16 Other (specify below)						
13 Insecticide storage						
Direction from well? How many feet?						
FROM TO LITHOLOGIC LOG FROM TO PLUGGING INTERVALS						
		0 5 top soil				
		5 17 hole plug (Bentonite)				
		Cut Casing off 5' down				
7 CONTRACTOR'S OR LANDOWNER'S CERTIFICATION: This water well was (1) constructed, (2) reconstructed, or (3) plugged under my jurisdiction and was completed on (mo/day/year) 2-21-91 and this record is true to the best of my knowledge and belief. Kansas Water Well Contractor's License No. 473 This Water Well Record was completed on (mo/day/yr) 2-28-91 under the business name of Tyler Water Well Service by (signature) <i>Tyler Water Well Service</i>						