


1 LOCATION OF WATER WELL: County: Greeley	Fraction SE 1/4 SE 1/4 NE 1/4	Section Number 11	Township Number T 16 S	Range Number R 39 E/W
--	----------------------------------	----------------------	---------------------------	--------------------------

Distance and direction from nearest town or city street address of well if located within city?

2 WATER WELL OWNER: VAUGHN M. YOUNG
 RR#, St. Address, Box #: RT 1 BOX 57
 City, State, ZIP Code: TRIBUNE KS 67879
 Board of Agriculture, Division of Water Resources
 Application Number: 39,612

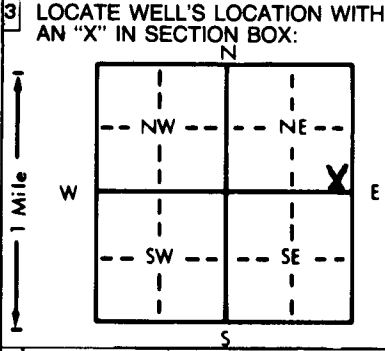

4 DEPTH OF COMPLETED WELL... 164 ft. ELEVATION: ...
 Depth(s) Groundwater Encountered 1... 73 ft. 2... ft. 3... ft.
 WELL'S STATIC WATER LEVEL ... 73 ft. below land surface measured on mo/day/yr ... 6-3-92
 Pump test data: Well water was ... 160 ft. after ... 4 hours pumping ... 600 gpm
 Est. Yield ... 600 gpm: Well water was ... ft. after ... hours pumping ... gpm
 Bore Hole Diameter ... 26 in. to ... ft., and ... in. to ... ft.
 WELL WATER TO BE USED AS:
 5 Public water supply 8 Air conditioning 11 Injection well
 1 Domestic 3 Feedlot 6 Oil field water supply 9 Dewatering 12 Other (Specify below)
 2 Irrigation 4 Industrial 7 Lawn and garden only 10 Monitoring well
 Was a chemical/bacteriological sample submitted to Department? Yes... No... ...; If yes, mo/day/yr sample was submitted
 Water Well Disinfected? Yes No

5 TYPE OF BLANK CASING USED:
 1 Steel 3 RMP (SR) 5 Wrought iron 8 Concrete tile CASING JOINTS: Glued ... Clamped ...
 2 PVC 4 ABS 6 Asbestos-Cement 9 Other (specify below) Welded ...
 7 Fiberglass Threaded ...
 Blank casing diameter ... 12 in. to ... 124 ft., Dia ... in. to ... ft., Dia ... in. to ... ft.
 Casing height above land surface ... 12 in., weight ... lbs./ft. Wall thickness or gauge No. SCH 40
 TYPE OF SCREEN OR PERFORATION MATERIAL:
 1 Steel 3 Stainless steel 5 Fiberglass 7 PVC 10 Asbestos-cement
 2 Brass 4 Galvanized steel 6 Concrete tile 8 RMP (SR) 11 Other (specify) ...
 9 ABS 12 None used (open hole)
 SCREEN OR PERFORATION OPENINGS ARE:
 1 Continuous slot 3 Mill slot 5 Gauzed wrapped 8 Saw cut 11 None (open hole)
 2 Louvered shutter 4 Key punched 6 Wire wrapped 9 Drilled holes
 7 Torch cut 10 Other (specify) ...
 SCREEN-PERFORATED INTERVALS: From ... 124 ft. to ... 164 ft., From ... ft. to ... ft.
 From ... ft. to ... ft., From ... ft. to ... ft.
 GRAVEL PACK INTERVALS: From ... 20 ft. to ... 164 ft., From ... ft. to ... ft.
 From ... ft. to ... ft., From ... ft. to ... ft.

6 GROUT MATERIAL: 1 Neat cement 2 Cement grout 3 Bentonite 4 Other ...
 Grout intervals: From ... 0 ft. to ... 20 ft., From ... ft. to ... ft., From ... ft. to ... ft.
 What is the nearest source of possible contamination:
 1 Septic tank 4 Lateral lines 7 Pit privy 10 Livestock pens 14 Abandoned water well
 2 Sewer lines 5 Cess pool 8 Sewage lagoon 11 Fuel storage 15 Oil well/Gas well
 3 Watertight sewer lines 6 Seepage pit 9 Feedyard 12 Fertilizer storage 16 Other (specify below)
 13 Insecticide storage None with ~~out~~
 Direction from well? How many feet? 1 mile

FROM	TO	LITHOLOGIC LOG	FROM	TO	PLUGGING INTERVALS
0	16	top soil & sand	160	164	clay
16	33	gravel	164	165	shale
33	48	sand (fine)	165	170	shale
48	49	limestone (hard)			
49	66	clay & little limestone			
66	81	limestone (3 1 ft streaks hard)			
81	82	sand			
82	90	cemented sand & little limestone (hard)			
90	99	sand (medium)			
99	115	sandy clay			
115	132	sand (medium)			
132	136	sand (medium to coarse)			
136	146	sandy clay			
146	148	sand (medium to coarse)			
148	160	sand (course)			

7 CONTRACTOR'S OR LANDOWNER'S CERTIFICATION: This water well was (1) constructed, (2) reconstructed, or (3) plugged under my jurisdiction and was completed on (mo/day/year) June 5, 1992 and this record is true to the best of my knowledge and belief. Kansas Water Well Contractor's License No. 473 This Water Well Record was completed on (mo/day/yr) July 2, 1992 under the business name of Tyler Water Well Service by (signature) *Tyler Water Well Service*