


USE TYPEWRITER OR BALL POINT PEN-PRESS FIRMLY, PRINT CLEARLY.

WATER WELL RECORD
KSA 82a-1201-1215

Kansas Department of Health and Environment—Division of Environment
(Water well Contractors)
Topeka, Kansas 66620

1. Location of well: County: GREELY Section: SW 1/4 NW 1/4 SW 1/4 Section number: 15 Township number: T 16 S R Range number: 39 2/W

2. Distance and direction from nearest town or city: from the stop light in Leoti, 12 North, 13 6/10 West, North side of road
Street address of well location if in city: North side of road
3. Owner of well: V.M. Young
R.R. or street: Tribune, Ks 67879
City, state, zip code:

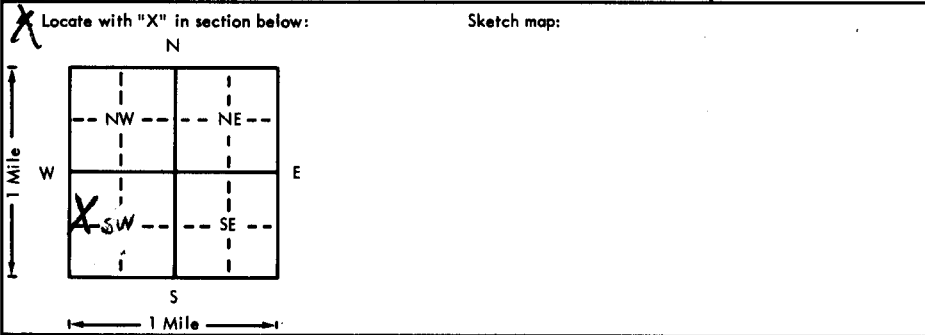

6. Bore hole dia. 26 in. Completion date 2-29-76
Well depth 188 ft.

7. Cable tool Rotary Driven Dug
Hollow rod Jetted Bored Reverse rotary

8. Use: Domestic Public supply Industry Irrigation Air conditioning Stock
Lawn Oil field water Other

Casing: Material Steel Weight: Above or below
Threaded Welded Surface 12 in. RMP
PVC Weight lbs./ft. Dia. 16 in. to 189 ft. depth Wall Thickness: inches or
Dia. in. to in. ft. depth gage No. 219

5. Type and color of material	From	To

10. Screen: Manufacturer's name Johnson Division
Type Galv Dia. 16"
Slot/gauze 100 Length 201
Set between 158 ft. and 178 ft. Perf. 110-158 ft. and 178-188 ft.
Gravel pack? yes Size range of material: 25" Down

11. Static water level: 122 ft. below land surface Date 1-21-76 mo./day/yr.

12. Pumping level below land surfaces: 152 ft. after 2 hrs. pumping 450 g.p.m.
ft. after hrs. pumping g.p.m.
Estimated maximum yield 450 g.p.m.

13. Water sample submitted: Yes No Date

14. Well head completion: Pitless adapter 12 inches above grade

15. Well grouted? yes
With: Neat cement Bentonite Concrete
Depth: From 0 ft. to 10 ft.

16. Nearest source of possible contamination: N/A ft. Direction Type
Well disinfected upon completion? Yes No

17. Pump: Goulds N/A installed
Manufacturer's name Goulds Model number 10JHMC HP 60 Volts 450
Length of drop pipe 180 ft. capacity 450 g.p.m. Type: Submersible Turbine Jet Reciprocating Centrifugal Other

18. Elevation: Topography: Hill Slope Upland Valley
19. Remarks: Surges After 161'

20. Water well contractor's certification: This well was drilled under my jurisdiction and this report is true to the best of my knowledge and belief.
Minter Wilson Drilling 208
Business name O. Box A Garden City, Ks
Address 6-31-76
Signed [Signature] Date 6-31-76
Authorized representative

The Professionals

MINTER-WILSON DRILLING CO.

INCORPORATED

Geological
and General
Water Systems
Development
and Drilling

Phone 276-3269

P.O. Box 493

GARDEN CITY, KANSAS 67846

V. M. Young
Greely County
12-30-75

Location: SW 15-16-39

From stop light in Leoti, 12 miles North, 13-6/10
miles West, North side of road

Static Water Level - 127'

Test #1

0	3	Top Soil
3	16	Brown Sandy Clay
16	27	Brown Sandy Clay & White Rock mixture
27	41	Fine to Med. Sand & Gravel (Tight)
41	50	Fine to Med. Sand & Gravel, Streaks of Clay & White Rock (20%)
50	62	Brown Sandy Clay & White Rock mixture
62	93	Brown Sandy Clay
93	127	Fine to Med. Sand, Streaks of Clay (20%)
127	143	Fine to Med. Sand & Fine Gravel, Streaks of Clay & White Rock (15%)(Tight)
143	148	Fine to Med. Sand & Gravel (Tight)
148	169	Fine to Med. Sand & Gravel (Little Tight)
169	172	Brown Clay
172	178	Fine to Med. Sand & Gravel
178	181	Yellow & White Clay
181	185	Shale

T.D. - 188'