


1 LOCATION OF WATER WELL: County: Greely Fraction: NW 1/4 NW 1/4 NW 1/4 Section Number: 18 Township Number: T 16 S Range Number: R 39 EW

Distance and direction from nearest town or city street address of well if located within city?
14N 4E of Tribune

2 WATER WELL OWNER: L. A. Peter
 RR#, St. Address, Box #: Tribune, Ks 67879
 City, State, ZIP Code: Tribune, Ks 67879
 Board of Agriculture, Division of Water Resources
 Application Number: 2396

3 LOCATE WELL'S LOCATION WITH AN "X" IN SECTION BOX:

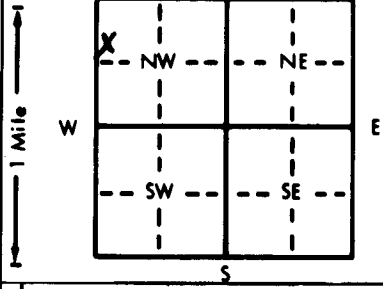

4 DEPTH OF COMPLETED WELL: 209 ft. ELEVATION: 3660
 Depth(s) Groundwater Encountered 1. 157 ft. 2. _____ ft. 3. _____ ft.
 WELL'S STATIC WATER LEVEL 157 ft. below land surface measured on mo/day/yr 11-10-87
 Pump test data: Well water was 200 ft. after 2 hours pumping 800 gpm
 Est. Yield 800 gpm: Well water was _____ ft. after _____ hours pumping _____ gpm
 Bore Hole Diameter: 2.8 in. to 2.09 ft., and _____ in. to _____ ft.
 WELL WATER TO BE USED AS:
 1 Domestic 3 Feedlot 6 Oil field water supply 9 Dewatering 12 Other (Specify below)
 2 Irrigation 4 Industrial 7 Lawn and garden only 10 Observation well
 Was a chemical/bacteriological sample submitted to Department? Yes _____ No ; If yes, mo/day/yr sample was submitted _____
 Water Well Disinfected? Yes _____ No

5 TYPE OF BLANK CASING USED:
 1 Steel 3 RMP (SR) 5 Wrought iron 8 Concrete tile CASING JOINTS: Glued _____ Clamped _____
 2 PVC 4 ABS 6 Asbestos-Cement 9 Other (specify below) Welded _____
 _____ 7 Fiberglass _____ Threaded _____
 Blank casing diameter 16 in. to 17.9 ft., Dia _____ in. to _____ ft., Dia _____ in. to _____ ft.
 Casing height above land surface 10 in., weight _____ lbs./ft. Wall thickness or gauge No. 219
 TYPE OF SCREEN OR PERFORATION MATERIAL:
 1 Steel 3 Stainless steel 5 Fiberglass 7 PVC 10 Asbestos-cement
 2 Brass 4 Galvanized steel 6 Concrete tile 9 ABS 12 None used (open hole)
 SCREEN OR PERFORATION OPENINGS ARE:
 1 Continuous slot 3 Mill slot 6 Wire wrapped 8 Saw cut 11 None (open hole)
 2 Louvered shutter 4 Key punched 7 Torch cut 9 Drilled holes 10 Other (specify) _____
 SCREEN-PERFORATED INTERVALS: From 179 ft. to 199 ft., From _____ ft. to _____ ft.
Screen From 199 ft. to 209 ft., From _____ ft. to _____ ft.
 GRAVEL PACK INTERVALS: From 20 ft. to 209 ft., From _____ ft. to _____ ft.
 From _____ ft. to _____ ft., From _____ ft. to _____ ft.

6 GROUT MATERIAL: 1 Neat cement 2 Cement grout 3 Bentonite 4 Other _____
 Grout intervals: From 0 ft. to 20 ft., From _____ ft. to _____ ft., From _____ ft. to _____ ft.
 What is the nearest source of possible contamination:
 1 Septic tank 4 Lateral lines 7 Pit privy 10 Livestock pens 14 Abandoned water well
 2 Sewer lines 5 Cess pool 8 Sewage lagoon 11 Fuel storage 15 Oil well/Gas well
 3 Watertight sewer lines 6 Seepage pit 9 Feedyard 12 Fertilizer storage 16 Other (specify below)
 13 Insecticide storage _____
 Direction from well? South How many feet? 90

FROM	TO	LITHOLOGIC LOG	FROM	TO	LITHOLOGIC LOG
0	5	top soil	180	195	Sand
5	15	clay	195	203	Sand
16	31	lime & clay	203	209	clay
31	32	lime very hard			
32	45	lime + little clay			
45	55	lime & sand			
55	75	lime & clay			
75	90	sand & 2' clay			
90	105	lime & sand			
105	120	lime & clay & 2' cem. sand			
120	135	clay & little sand			
135	142	cemented sand			
142	150	sand + little sand & clay			
150	165	sand & little clay			
165	180	sand			

7 CONTRACTOR'S OR LANDOWNER'S CERTIFICATION: This water well was (1) constructed, (2) reconstructed, or (3) plugged under my jurisdiction and was completed on (mo/day/year) 11-10-87 and this record is true to the best of my knowledge and belief. Kansas Water Well Contractor's License No. 473 This Water Well Record was completed on (mo/day/yr) 11-18-87 under the business name of Tyler Water Well Serv by (signature) Dustin Saly

INSTRUCTIONS: Use typewriter or ball point pen. PLEASE PRESS FIRMLY and PRINT clearly. Please fill in blanks, underline or circle the correct answers. Send top three copies to Kansas Department of Health and Environment, Office of Oil Field and Environmental Geology, Regulation and Permitting Section, Topeka, Kansas 66620-7500, Telephone: 913-862-9360. Send one to WATER WELL OWNER and retain one for your records.