

USE TYPEWRITER OR BALL POINT PEN-PRESS FIRMLY, PRINT CLEARLY.


WATER WELL RECORD
KSA 82a-1201-1215

Kansas Department of Health and Environment-Division of Environment
(Water well Contractors)
Topeka, Kansas 66620

Location of well: **GREELEY** County **NW 1/4 NW 1/4 SW 1/4** Section number **20** Township number **T 16 S R 39 E/W**

1. Distance and direction from nearest town or city: **13 mi. NORTH**
4 mi. EAST
Street address of well location if in city: **4 1/2 mi. SOUTH**
OF TRIBUNE, KS

3. Owner of well: **L. A. PETER**
R.R. or street:
City, state, zip code: **TRIBUNE, KANS. 67879**

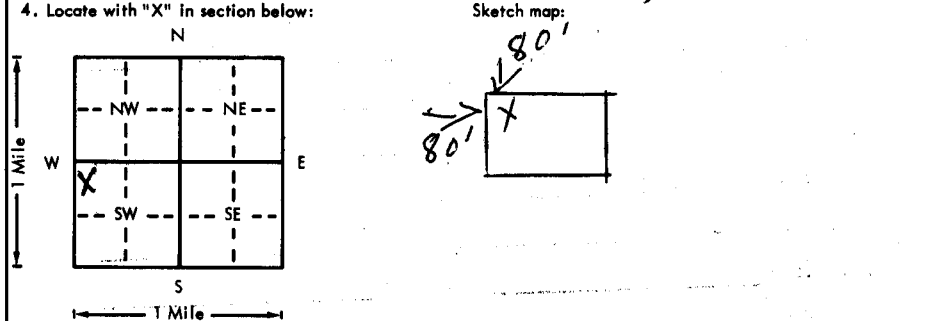

6. Bore hole dia. **2 1/2** in. Completion date **12-26-75**
Well depth **190** ft.

7. Cable tool Rotary Driven Dug
 Hollow rod Jetted Bored Reverse rotary

8. Use: Domestic Public supply Industry
 Irrigation Air conditioning Stock
 Lawn Oil field water Other

9. Casing: Material **STEEL** Height: **Above** or below
Threaded Welded Surface **12** in.
RMP PVC Weight **40** lbs./ft.
Dia. **1 1/2** in. to **4 1/2** ft. depth Wall Thickness: inches or
Dia. in. to ft. depth gage No. **219**

5. Type and color of material	From	To
OVERBURDEN	0	130
SAND	130	135
SAND + 1' CLAY	135	140
CLAY, LIME & CEMENTED SAND	140	150
SAND, LIME, + CEMENTED SAND	150	166
CLAY, LIME & CEMENTED SAND	166	172
SAND, LIME & CEMENTED SAND	172	177
CEMENTED SAND (HARD)	177	178
SAND	178	180
CLAY & LIME	180	184
SAND	184	185
CLAY	185	190

10. Screen: Manufacturer's name **W. A. Brown**
Type **FREEFLOW** Dia. **1 1/2**
Slot/gauze **SLOT** Length **50'**
Set between **140** ft. and **190** ft.
Gravel pack? YES Size range of material **5/8**

11. Static water level: **134** ft. below land surface Date **12-27-75** mo./day/yr.

12. Pumping level below land surfaces:
190 ft. after **7** hrs. pumping **600** g.p.m.
ft. after _____ hrs. pumping _____ g.p.m.
Estimated maximum yield **600** g.p.m.

13. Water sample submitted: _____ mo./day/yr.
Yes No Date _____

14. Well head completion:
Pitless adapter **12** inches above grade

15. Well grouted? YES
With: Neat cement Bentonite Concrete
Depth: From **0** ft. to **10** ft.

16. Nearest source of possible contamination:
ft. _____ Direction _____ Type **NONE**
Well disinfected upon completion? Yes No

17. Pump: _____ Not installed
Manufacturer's name **LAYNE**
Model number **79405R** HP **40** Volts **440**
Length of drop pipe **180** ft. capacity **500** g.p.m.
Type:
 Submersible Turbine
 Jet Reciprocating
 Centrifugal Other

18. Elevation: _____

19. Remarks: **LEVEL**

Topography:
 Hill
 Slope
 Upland
 Valley

20. Water well contractor's certification:
This well was drilled under my jurisdiction and this report is true to the best of my knowledge and belief.

ARK VALLEY Pump & Supply 123
Business name _____ License No. _____
Address **Box 235 - Holly, Colo**
Signed **Wm Smith** Date **2-10-76**
Authorized representative

T 16 S R 39 E/W NW 1/4 SW 1/4