


1 LOCATION OF WATER WELL: Fraction **NE 1/4 SE 1/4 NE 1/4** Section Number **20** Township Number **T 16 S** Range Number **R 39 X2W**
 County: **Greeley**

Distance and direction from nearest town or city street address of well if located within city?
13 miles north, 5 1/2 east Tribune

2 WATER WELL OWNER: **L.A. Peter**
 RR#, St. Address, Box # : **Rt 1 Box 49** Board of Agriculture, Division of Water Resources
 City, State, ZIP Code : **Tribune, KS 67879** Application Number: **23701**

3 LOCATE WELL'S LOCATION WITH AN "X" IN SECTION BOX:

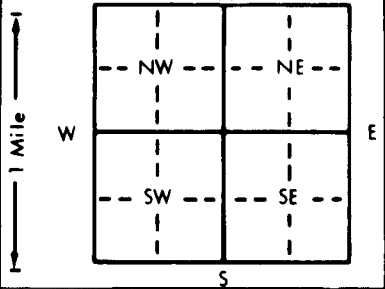

4 DEPTH OF COMPLETED WELL: **181** ft. ELEVATION: **3660**
 Depth(s) Groundwater Encountered 1. **151** ft. 2. _____ ft. 3. _____ ft.
 WELL'S STATIC WATER LEVEL **151** ft. below land surface measured on mo/day/yr **12-15-90**
 Pump test data: Well water was **180** ft. after **3** hours pumping **200** gpm
 Est. Yield **200** gpm Well water was _____ ft. after _____ hours pumping _____ gpm
 Bore Hole Diameter **26** in. to _____ ft. and _____ in. to _____ ft.
 WELL WATER TO BE USED AS:
 5 Public water supply 8 Air conditioning 11 Injection well
 1 Domestic 3 Feedlot 6 Oil field water supply 9 Dewatering 12 Other (Specify below)
 2 Irrigation 4 Industrial 7 Lawn and garden only 10 Monitoring well
 Was a chemical/bacteriological sample submitted to Department? Yes _____ No **X**; If yes, mo/day/yr sample was submitted _____
 Water Well Disinfected? Yes **X** No _____

5 TYPE OF BLANK CASING USED:
 1 Steel 3 RMP (SR) 5 Wrought iron 8 Concrete tile CASING JOINTS: Glued **X** Clamped _____
 2 PVC 4 ABS 6 Asbestos-Cement 9 Other (specify below) Welded _____
 7 Fiberglass Threaded _____
 Blank casing diameter **16** in. to _____ ft. Dia _____ in. to _____ ft. Dia _____ in. to _____ ft.
 Casing height above land surface **12** in. weight _____ lbs./ft. Wall thickness or gauge No. **Sch 40**
 TYPE OF SCREEN OR PERFORATION MATERIAL:
 1 Steel 3 Stainless steel 5 Fiberglass 7 PVC 10 Asbestos-cement
 2 Brass 4 Galvanized steel 6 Concrete tile 8 RMP (SR) 11 Other (specify) _____
 9 ABS 12 None used (open hole)
 SCREEN OR PERFORATION OPENINGS ARE:
 1 Continuous slot 3 Mill slot 5 Gauzed wrapped 8 Saw cut 11 None (open hole)
 2 Louvered shutter 4 Key punched 6 Wire wrapped 9 Drilled holes
 7 Torch cut 10 Other (specify) _____
 SCREEN-PERFORATED INTERVALS: From **141** ft. to **181** ft. From _____ ft. to _____ ft.
 From _____ ft. to _____ ft. From _____ ft. to _____ ft.
 GRAVEL PACK INTERVALS: From **20** ft. to **181** ft. From _____ ft. to _____ ft.
 From _____ ft. to _____ ft. From _____ ft. to _____ ft.

6 GROUT MATERIAL: 1 Neat cement 2 Cement grout 3 Bentonite 4 Other _____
 Grout Intervals: From **0** ft. to **20** ft. From _____ ft. to _____ ft. From _____ ft. to _____ ft.
 What is the nearest source of possible contamination:
 1 Septic tank 4 Lateral lines 7 Pit privy 10 Livestock pens 14 Abandoned water well
 2 Sewer lines 5 Cess pool 8 Sewage lagoon 11 Fuel storage 15 Oil well/Gas well
 3 Watertight sewer lines 6 Seepage pit 9 Feedyard 12 Fertilizer storage 16 Other (specify below)
 13 Insecticide storage _____
 Direction from well? **south** How many feet? **290 ft**

FROM	TO	LITHOLOGIC LOG	FROM	TO	PLUGGING INTERVALS
0	16	top soil & limestone			
16	33	limestone (6' very very hard)			
33	49	sand & clay streaks			
49	66	XXXXXXXXXXXX limestone & sand (hgrd)			
66	99	sand & clay XXXXXXXX balls			
99	115	sand & clay streaks			
115	146	sandy clay & 5' sand			
146	177	sand (medium to coarse)			
177	180	clay			
180	181	shale			

7 CONTRACTOR'S OR LANDOWNER'S CERTIFICATION: This water well was (1) constructed, (2) reconstructed, or (3) plugged under my jurisdiction and was completed on (mo/day/year) **12-20-90** and this record is true to the best of my knowledge and belief. Kansas Water Well Contractor's License No. **473** This Water Well Record was completed on (mo/day/yr) **1-20-91** under the business name of **Tyler Water Well Service** by (signature) *Daryl E. Tyler*