


USE TYPEWRITER OR BALL POINT PEN-PRESS FIRMLY, PRINT CLEARLY.

WATER WELL RECORD  
KSA 82a-1201-1215

Kansas Department of Health and Environment-Division of Environment (Water well Contractors) Topeka, Kansas 66620

1. Location of well: County Greeley Fraction NW 1/4NW 1/4SW 1/4 Section number 21 Township number T 16 S R 39 Range number E/W

2. Distance and direction from nearest town or city: 1 1/2 N., 5 1/2 E. & 1/2 S. of Tribune, Kansas  
Street address of well location if in city: Kansas  
3. Owner of well: L. A. Peter  
R.R. or street: Tribune, Kans. 67879  
City, state, zip code: Tribune, Kans. 67879

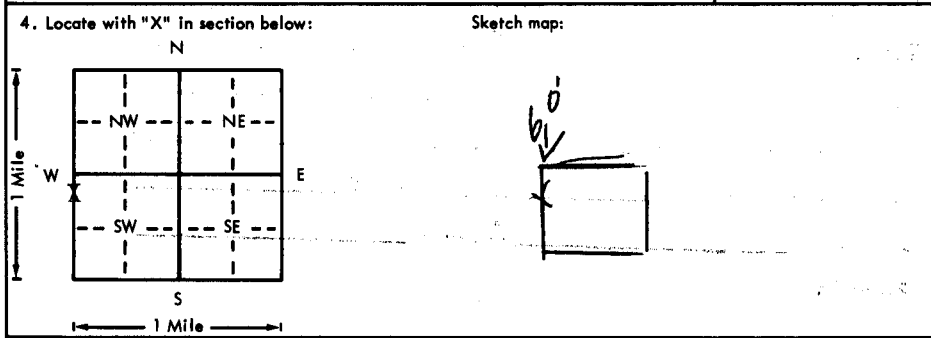

6. Bore hole dia. 26 in. Completion date 12-27-75  
Well depth 180 ft.  
7.  Cable tool  Rotary  Driven  Dug  
 Hollow rod  Jetted  Bored  Reverse rotary  
8. Use:  Domestic  Public supply  Industry  
 Irrigation  Air conditioning  Stock  
 Lawn  Oil field water  Other  
9. Casing: Material Steel Height: Above or below  
Threaded  Welded  Surface 12 in.  
RMP  PVC  Weight 40 lbs./ft.  
Dia. 16 in. to 130 ft. depth! Wall Thickness: inches or  
Dia.     in. to     ft. depth! gauge No. 219

5. Type and color of material	From	To
Overburden	0	60
Sand & clay	60	105
Clay & little lime	105	141
Sand with 2 <sup>nd</sup> Clay	141	157
Cemented sand (hard)	157	158
Sand & clay	158	166
Clay	166	169
Sand	169	173
Clay	173	178
Shale	178	180
(Use a second sheet if needed)		

10. Screen: Manufacturer's name W. A. Brown  
Type Free Flo Dia. 16  
Slot/gauze slot Length 50 ft  
Set between 130 ft. and 180 ft.  
Gravel pack?  Yes Size range of material 5/8  
11. Static water level: 134 ft. below land surface Date 12-29-75 mo./day/yr.  
12. Pumping level below land surfaces:  
180 ft. after 7 hrs. pumping 600 g.p.m.  
    ft. after     hrs. pumping     g.p.m.  
Estimated maximum yield 600 g.p.m.  
13. Water sample submitted:     mo./day/yr.  
 Yes  No Date      
14. Well head completion:  
 Pitless adapter 18" inches above grade  
15. Well grouted?  Yes  
With:  Neat cement  Bentonite  Concrete  
Depth: From 0 ft. to 10 ft.  
16. Nearest source of possible contamination:  
ft.     Direction     Type None  
Well disinfected upon completion?  Yes  No  
17. Pump:  Not installed  
Manufacturer's name Layne  
Model number 79503K HP 25 Volts 440  
Length of drop pipe 180 ft. capacity 400 g.p.m.  
Type:  
 Submersible  Turbine  
 Jet  Reciprocating  
 Centrifugal  Other

18. Elevation:      
Topography:  Hill  Slope  Upland  Valley  
19. Remarks: Level ground

20. Water well contractor's certification:  
This well was drilled under my jurisdiction and this report is true to the best of my knowledge and belief.  
ARK VALLEY PUMP & SUPPLY 123  
Business name Box 235 Holly, Colo. License No.      
Address      
Signed David Smith Date 2-25-76  
Authorized representative

16 370 21- NUBUSAL