

WATER WELL PLUGGING RECORD Form WWC-5P

KSA 82a-1212

ID NO.

9501

1 LOCATION OF WATER WELL: County: <u>GREELY</u>	Fraction <u>1/4 1/4 NW 1/4 NW 1/4</u>	Section Number <u>18</u>	Township Number <u>T 16 S</u>	Range Number <u>39</u> <input type="checkbox"/> E <input checked="" type="checkbox"/> W
---	--	-----------------------------	----------------------------------	--

Street/Rural Address of Well Location; if unknown, distance & direction from nearest town or intersection: If at owner's address, check here 13 miles north and 4 miles east of

Tribune Kansas

Global Positioning Systems (GPS) information:

Latitude: N 38.66720 (in decimal degrees)

Longitude: W 101.67817 (in decimal degrees)

Elevation:

Datum: WGS84, NAD83, NAD27

Collection Method:


GPS unit (Make/Model: MAGELLAN eXplorist)

Digital Map/Photo, Topographic Map, Land Survey

Est. Accuracy: < 3 m, 3-5 m, 5-15 m, > 15 m

2 WATER WELL OWNER: Seaboard Foods LLC.
RR#, St. Address, Box #: 2801 Hurliman Road
City, State ZIP Code: Guymon Ok. 73942

3 MARK WELL'S LOCATION WITH AN "X" IN SECTION BOX:

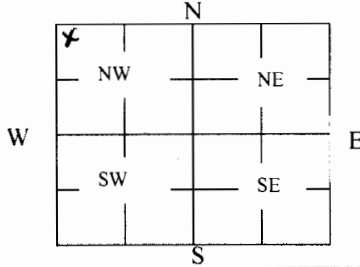

4 DEPTH OF WELL 198 ft.

WELL'S STATIC WATER LEVEL 176 ft

WELL WAS USED AS:

- Domestic
- Irrigation
- Feedlot
- Industrial

- Public Water Supply
- Oil Field Water Supply
- Domestic (Lawn & Garden)
- Air Conditioning

- Dewatering
- Monitoring
- Injection Well
- Other _____

Was a chemical/bacteriological sample submitted to Department? Yes No

5 TYPE OF BLANK CASING USED:

- Steel
- RMP (SR)
- Wrought
- Fiberglass
- Other (Specify below) _____
- PVC
- ABS
- Asbestos-Cement
- Concrete Tile

Blank casing diameter 16 in. Was casing pulled? Yes No If yes, how much 60"
Casing height above or below land surface below 60" in.

6 GROUT PLUG MATERIAL:

- Neat cement
- Cement grout
- Bentonite
- Other _____

Grout Plug Intervals: From 10 ft. to 5 ft., From _____ ft. to _____ ft., From _____ to _____ ft.

What is the nearest source of possible contamination:

- Septic tank
- Sewer lines
- Watertight sewer lines
- Lateral lines
- Cess pool
- Seepage pit
- Pit privy
- Sewage lagoon
- Feedyard
- Livestock pens
- Fuel Storage
- Fertilizer storage
- Insecticide storage
- Abandoned water well
- Oil well/Gas well
- Other (specify below) None Observed

Direction from well? _____
How many feet? _____

FROM	TO	PLUGGING MATERIALS	FROM	TO	PLUGGING MATERIALS
198'	176'	Chlorinated Road Sand	176'	10'	Dirty oversized rock w/clay chunks
10'	5'	3,000 PSI Concrete	5'	0'	Dug down, cut off casing, backfill

7 CONTRACTOR'S OR LANDOWNER'S CERTIFICATION: This water well was plugged under my jurisdiction and was completed on (mo/day/year) 3-28-2012 and this record is true to the best of my knowledge and belief. Kansas Water Well Contractor's License No. 145. This Water Well Record was completed on (mo/day/year) 4-4-2012 under the business name of Hydro Resources Mid Continent by (signature) Gary Clepper

INSTRUCTIONS: Use typewriter or ballpoint pen. Please press firmly and print clearly. Please fill in blanks, underline or circle the correct answers. Send top three copies to Kansas Department of Health and Environment, Bureau of Water, Geology Section, 1000 SW Jackson St., Ste. 420, Topeka, Kansas 66612-1367. Telephone: 785/296-5524. Send one to Water Well Owner and retain one for your records. Visit us at <http://www.kdheks.gov/waterwell/index.html>.

Check one: White Copy Blue Copy Pink Copy